

Registration Statement

OF CLAIMANT OF RIGHT TO APPROPRIATE GROUND WATER

(Under Chapter 708, Oregon Laws 1955.)

TO THE STATE ENGINEER OF OREGON:

I, Walburga
William and Walburga Krebs
of 2415 12th St., Salem County of Marion

State of Oregon, do hereby make application for a certificate of registration as evidence of a right to appropriate ground water.

1. Source from which water is withdrawn is Pump Well #2
(Flowing well, pump well, infiltration trench, or tunnel)
2. Location is: 2 miles west of Talbot
(Approximate distance and direction from nearest city or town)

and is more particularly described as follows:

(a) N. 89° 20' W. 1272.0 ft. from S.E. Corner W. Wood D.L.C. #55
(Give distance and bearing to corner of section or other legal subdivision)
being within SE 1/4 of NW 1/4 of Sec. 25, Twp. 9S, Rge. 4W
(Smallest legal subdivision) (N. or S.) (E. or W.)

or (b) within limits of recorded platted property, town or city:

in Lot _____, Block _____ of _____
(Name of plat or addition)
County of _____
(If within city or town, give name)

3. Construction Work was begun on June 1934; was completed on June 1934
(Date) (Date)
and the ground water claimed was first used for the purposes set out below on July 1934
(Date)

since which time the water has been used continuously
(Continuously or intermittently)
from July 1934 to August 1, 1958 during irrigating seasons.
(Date) (Date)

4. Quantity of water claimed and used is 550 gallons per minute; _____ acre feet per year.

5. Purpose or Purposes for which water is used _____
Irrigation
(Domestic, irrigation, municipal, manufacturing, industrial, etc.)

6. Description of Well: Depth 30.0 feet. Type drilled
(Dug or drilled)
diameter 12 inches. Elevation of ground at well site 165.0 feet, mean sea level.
(As near as known)
Depth to water table 13.0 feet.

7. Capacity of Well: 550 g.p.m. with no feet drawdown.
_____ g.p.m. with _____ feet drawdown.

Date of test _____

If Flowing Well: Measured discharge _____ g.p.m. on _____
(Date)

Shut-in pressure at ground surface _____ lbs. per sq. in. on _____
(Date)

Water is controlled by _____
(Cap, valve, etc.)

If log of well is not available, give name and address of driller.

Sloper Plow Co., Independence, Oregon

11. Infiltration Trench: Covered or open

Dimensions: Length ft. Minimum depth ft. Maximum depth ft.

Bottom width ft. Discharge g.p.m. Date of test

12. Tunnel: Type of lining

Dimensions:
(Length, course, and cross sectional size)

Position of water bearing stratum with reference to portal of tunnel

Log of tunnel: (Preceding table for log of well may be used, if desired. Give footage from portal and character of materials, as pertinent.)

13. Pumping Equipment:

(a) Pump A-C Cent. Dir. Dr. 4"x2" Capacity g.p.m.
(Make, type and size)


(b) Motor Allis-Chalmers 15 hp. electric
(Type and horsepower)

14. Location of area irrigated or to be irrigated, or place of use if for purposes other than irrigation.

Township North or South	Range E. or W. of Willamette Meridian	Section	Forty-acre Tract	Number Acres To Be Irrigated	Date of Reclamation
9S	4WWM	24	NWSW	3.9	1934
"	"	"	NESW	16.4	"
"	"	"	SWSW	9.6	"
"	"	"	SESW	40.0	"
"	"	"	NWSE	3.3	"
"	"	"	SWSE	8.0	"
"	"	25	NWNW	9.6	"
"	"	"	NENW	35.0	"
"	"	"	SWNW	4.1	"
"	"	"	SENW	11.7	"
"	"	"	NWNE	4.6	"
			Total	146.2	"

15. If the ground water supply is supplemental to an existing water supply, identification of any application for a permit, permit, certificate or adjudicated right to appropriate water made or held by the registrant.

Township 95 Range 4W W.M.
North

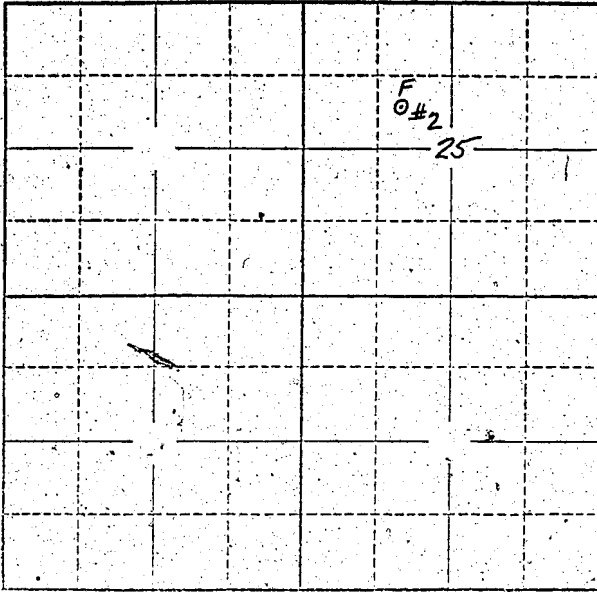

Locate well and acreage of irrigated land on plat.
Scale: 2" = 1 Mile

STATE OF OREGON }
County of Marion } ss.

I, William Krebs, being first duly sworn, do hereby certify that I have read the foregoing Registration Statement and that all of the items therein contained are true to the best of my knowledge and belief.

William Krebs
William Krebs
(Signature of Registrant)

Subscribed and sworn to before me this 28 day of July, 1958

My commission expires April 6 1959 Wm. Blum
(Notary Public)

(SEAL)

CERTIFICATE OF REGISTRATION

STATE OF OREGON }
County of Marion } ss.

This is to certify that the foregoing Registration Statement was received in the office of the State Engineer on the 30th day of July, 1958, at 2:00 o'clock P M and has been duly recorded in said office in Book No. 12 of Registration Statements on page GR-2876

~~Construction shall be completed by 12 o'clock and the water completely opened for beneficial use by 12 o'clock.~~

Witness my hand this 25th day of May, 1959

Lewis A. Stanley
(State Engineer)

27.85

By _____ (Deputy)
GR-2876