

Registration Statement

OF CLAIMANT OF RIGHT TO APPROPRIATE GROUND WATER

TO THE STATE ENGINEER OF OREGON:

I, Earl Hillispe
of 1615 So 25th St Salem County of Marion
(Mailing address)

State of Oregon, do hereby make application for a certificate of registration as evidence of a right to appropriate ground water.

1. Source from which water is withdrawn is Pump Well #1
(Flowing well, pump well, infiltration trench, or tunnel)

2. Location is: 9 miles southwest of Corvallis
(Approximate distance and direction from nearest city or town)

and is more particularly described as follows:

(a) 34.1 chains South and 4.1 chains East of the northwest corner of D.L.C. No. 41
(Give distance and bearing to corner of section or other legal subdivision)

being within SE $\frac{1}{4}$ of SE $\frac{1}{4}$ of Sec. 7, Twp. 13 S., Rge. 5 W.
(Smallest legal subdivision) (S. or S.) (E. or W.)

or (b) within limits of recorded platted property, town or city:

in Lot Block of
(Name of plat or addition)

County of
(If within city or town, give name)

3. Construction Work was begun on April 1950; was completed on April 1950
(Date) (Date)

and the ground water claimed was first used for the purposes set out below on April 1950
(Date)

since which time the water has been used intermittently during season
(Continuously or intermittently)

from April 1950 to Oct 1957
(Date) (Date)

4. Quantity of water claimed and used is 70 gallons per minute; acre feet per year.

5. Purpose or Purposes for which water is used Irrigation

(Domestic, irrigation, municipal, manufacturing, industrial, etc.)

6. Description of Well: Depth 45 feet. Type Drilled
(Dug or drilled)

diameter 8 inches. Elevation of ground at well site feet, mean sea level.

Depth to water table 8 feet.
(As near as known)

7. Capacity of Well: 70 g.p.m. with 30 feet drawdown.

g.p.m. with feet drawdown.

Date of test During Pumping

If Flowing Well: Measured discharge g.p.m. on
(Date)

Shut-in pressure at ground surface lbs. per sq. in. on
(Date)

Water is controlled by
(Cap, valve, etc.)

8. Casing: (Give diameter, commercial specifications and depth below ground surface of each casing size.)

8 inch diameter steel casing from 0 to 45 feet

inch diameter from to feet

inch diameter from to feet

inch diameter from to feet

Describe and show depth of shoe, plug, adapter, liner or other details:

9. Perforated Casings or Screens:

yes from 27 to 45
(Number per foot and size of perforations, or describe screen)

from to

from to

from to

10. Log of Well: (Describe each stratum or formation clearly, indicate if water bearing, and give thickness and depth as indicated.)

MATERIAL	Thickness (Feet)	Depth to Bottom (Feet)
<u>Top Soil</u>	<u>0</u>	<u>18</u>
<u>Gravel</u>	<u>18</u>	<u>45</u>
		<u>0</u>

If log of well is not available, give name and address of driller, C.A. Shafer

11. Infiltration Trench: Covered or open
 Dimensions: Length ft. Minimum depth ft. Maximum depth ft.
 Bottom width ft. Discharge g.p.m. Date of test

12. Tunnel: Type of lining
 Dimensions:
(Length, course, and cross sectional size)
 Position of water bearing stratum with reference to portal of tunnel

Log of tunnel: (Preceding table for log of well may be used, if desired. Give footage from portal and character of materials, as pertinent.)


13. Pumping Equipment:
 (a) Pump Fairbanks-Morse Turbine Capacity 100 g.p.m.
(Make, type and size)
 (b) Motor 5 H.P. Electric
(Type and horsepower)

14. Location of area irrigated or to be irrigated, or place of use if for purposes other than irrigation.

Township North or South	Range E. or W. of Willamette Meridian	Section	Forty-acre Tract	Number Acres To Be Irrigated	Date of Reclamation
13 S.	5 W.	7	SE_{1/4}, NE_{1/4}	12.0	1950
"	"	"	NE _{1/4} , SE _{1/4}	20.2	"
"	"	"	SE _{1/4} , SE _{1/4}	20.3	"
"	"	18	NE _{1/4} , NE _{1/4}	1.2	"
				<u>41.7</u>	"
				(Acreage includes roads)	

15. If the ground water supply is supplemental to an existing water supply, identification of any application for a permit, permit, certificate or adjudicated right to appropriate water made or held by the registrant.

Township 35 Range 5W, W.M.
North

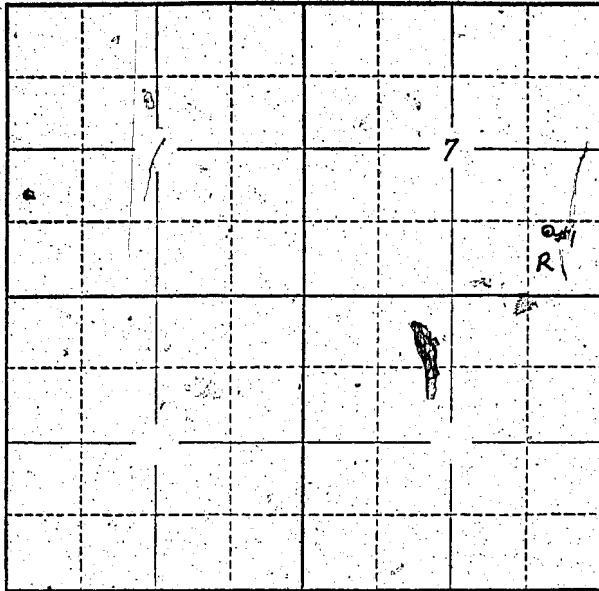

Locate well and acreage of irrigated land on plat.
Scale: 2" = 1 Mile

STATE OF OREGON

County of Marion } ss.

I, Earl Hillaspie, being first duly sworn, do hereby certify that I have read the foregoing Registration Statement and that all of the items therein contained are true to the best of my knowledge and belief.

Earl Hillaspie
(Signature of Registrant)

Subscribed and sworn to before me this 30th day of July, 1958

My commission expires 12th June 1961 Wm. S. Bartholomew
(Notary Public)

(SEAL)

CERTIFICATE OF REGISTRATION

STATE OF OREGON } ss.
County of Marion

This is to certify that the foregoing Registration Statement was received in the office of the State Engineer on the 30th day of July, 1958, at 10:00 o'clock A.M. and has been duly recorded in said office in Book No. 12 of Registration Statements on page 62 2879

Witness my hand this 25th day of May, 1959

Lewis A. Stanley
(State Engineer)

By _____
(Deputy)

16-80