

Registration Statement

OF CLAIMANT OF RIGHT TO APPROPRIATE GROUND WATER

TO THE STATE ENGINEER OF OREGON:

I, August Henry Schmidt

of 5340 Hayesville Drive

(Mailing address)

County of Marion

State of Oregon, do hereby make application for a certificate of registration as evidence of a right to appropriate ground water.

1. Source from which water is withdrawn is Pump well

(Flowing well, pump well, infiltration trench, or tunnel)

2. Location is: 4 miles northeast of Salem

(Approximate distance and direction from nearest city or town)

and is more particularly described as follows:

(a) N 89° 49' W - 97.2 FEET S 9° W - 2362 FEET FROM N.E. CORNER

(Give distance and bearing to corner of section or other legal subdivision)

being within N.W. 1/4 S.E. 1/4 of Sec. 5, Twp. 7 S., Rge. 2 W.

(Smallest legal subdivision)

(N. or S.)

(E. or W.)

or (b) within limits of recorded platted property, town or city:

in Lot _____, Block _____ of _____

(Name of plat or addition)

County of _____

(If within city or town, give name)

3. Construction Work was begun on 1947; was completed on 1947

(Date)

(Date)

and the ground water claimed was first used for the purposes set out below on 1947

(Date)

since which time the water has been used CONTINUOUSLY

(Continuously or intermittently)

from 1947 to Oct 1958

(Date)

(Date)

4. Quantity of water claimed and used is 40 gallons per minute; 1.5 acre feet per year.

5. Purpose or Purposes for which water is used IRRIGATION

(Domestic, irrigation, municipal, manufacturing, industrial, etc.)

6. Description of Well: Depth 67 feet. Type DRILLED

(Dug or drilled)

diameter 6 inches. Elevation of ground at well site _____ feet, mean sea level.

(As near as known)

Depth to water table 2.3 feet.

7. Capacity of Well: 45 g.p.m. with 50 feet drawdown.

_____ g.p.m. with _____ feet drawdown.

Date of test _____

If Flowing Well: Measured discharge _____ g.p.m. on _____

(Date)


Shut-in pressure at ground surface _____ lbs. per sq. in. on _____

(Date)

Water is controlled by _____

(Cap, valve, etc.)

Township 7S Range 2W, W.M.
North

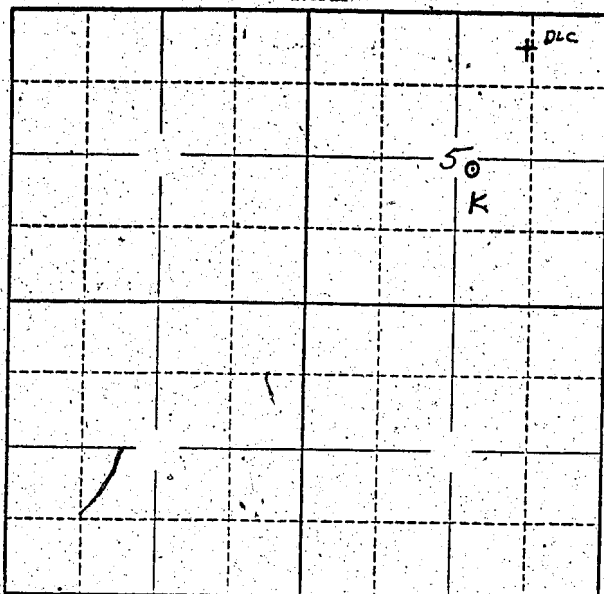

Locate well and acreage of irrigated land on plat.
Scale: 2" = 1 Mile

STATE OF OREGON

County of Marion } ss.

I, August Henry Schmidt, being first duly sworn, do hereby certify that I have read the foregoing Registration Statement and that all of the items therein contained are true to the best of my knowledge and belief.

August Henry Schmidt
(Signature of Registrant)

Subscribed and sworn to before me this 29th day of July, 19 58

My commission expires March 23, 1960

W. W. Lohr
(Notary Public)

(SEAL)

CERTIFICATE OF REGISTRATION

STATE OF OREGON }
County of Marion } ss.

This is to certify that the foregoing Registration Statement was received in the office of the State Engineer on the 30 day of July, 1958, at 8:00 o'clock A. M. and has been duly recorded in said office in Book No. 12 of Registration Statements on page GR 2889

Witness my hand this 25th day of May, 1959

Leora A. Stanley
(State Engineer)

By _____
(Deputy)

#15.00