

Registration Statement

OF CLAIMANT OF RIGHT TO APPROPRIATE GROUND WATER

TO THE STATE ENGINEER OF OREGON:

I, RALPH M. VAN KIRK

of 355 SPRING CREEK DRIVE, EUGENE County of LANE

State of OREGON, do hereby make application for a certificate of registration as evidence of a right to appropriate ground water.

1. Source from which water is withdrawn is PUMP WELL
(Flowing well, pump well, infiltration trench, or tunnel)

2. Location is: 6 1/2 MILES NORTH of EUGENE, OREGON
(Approximate distance and direction from nearest city or town)

and is more particularly described as follows:

(a) 200' SOUTH 1500' WEST 669' SOUTH 10' WEST
NW 1/4 AVE 4 (give distance and bearing to corner of section or other legal subdivision)
being within NORTHEAST CORNER of Sec. 2, Twp. 17 S Rge. 401
(Smallest legal subdivision) (N. or S.) (E. or W.)

or (b) within limits of recorded platted property, town or city:

in Lot 6, Block _____ of HANSEN'S RIVERVIEW ACRES
(Name of plat or addition)
County of LANE
(If within city or town, give name)

3. Construction Work was begun on MAY 15, 1955; was completed on MAY 15, 1955
(Date) (Date)

and the ground water claimed was first used for the purposes set out below on MAY 17, 1955
(Date)

since which time the water has been used INTERMITTENTLY
(Continuously or intermittently)

from MAY to OCTOBER
(Date) (Date)

4. Quantity of water claimed and used is 100 gallons per minute; 4 acre feet per year.

5. Purpose or Purposes for which water is used IRRIGATION BY LEACH

(Domestic, irrigation, municipal, manufacturing, industrial, etc.)

6. Description of Well: Depth 20 feet. Type DRILLED DRIVEN
(Dug or drilled)

diameter FOUR inches. Elevation of ground at well site _____ feet, mean sea level.
(As near as known)

Depth to water table _____ feet.

7. Capacity of Well: 100 g.p.m. with _____ feet drawdown.

_____ g.p.m. with _____ feet drawdown.


Date of test NOT KNOWN

If Flowing Well: Measured discharge _____ g.p.m. on _____
(Date)

Shut-in pressure at ground surface _____ lbs. per sq. in. on _____
(Date)

Water is controlled by _____
(Cap, valve, etc.)

Township 17S, Range 4W, W.M.
North.

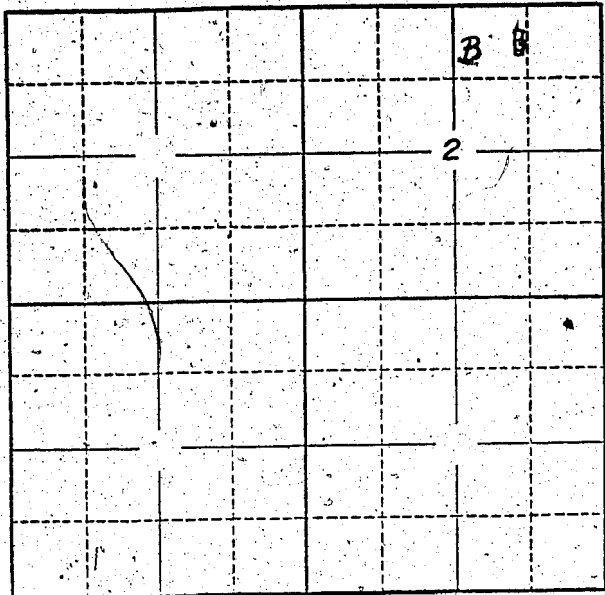

Locate well and acreage of irrigated land on plat.
Scale: 2" = 1 Mile

STATE OF OREGON }
County of LANE } ss.

I, RALPH M. VAN KIRK, being first duly sworn, do hereby certify that I have read the foregoing Registration Statement and that all of the items therein contained are true to the best of my knowledge and belief.

Ralph M. Van Kirk
(Signature of Registrant)

Subscribed and sworn to before me this 29TH day of July, 1958

My commission expires AUGUST 20 1960
(Notary Public)

(SEAL)

CERTIFICATE OF REGISTRATION

STATE OF OREGON }
County of Marion } ss.

This is to certify that the foregoing Registration Statement was received in the office of the State Engineer on the 30 day of July, 1958, at 8:00 o'clock A.M. and has been duly recorded in said office in Book No. 12 of Registration Statements on page GR 2890

Witness my hand this 25th day of May, 1959

Laura A. Stanley
(State Engineer)

By _____
(Deputy)

GR - 2890

\$15.00