

RECEIVED
JUL 30 1958

STATE ENGINEER
SALEM, OREGON

Registration No. GR - 3092

Certificate No. GR - 2900

Registration Statement

OF CLAIMANT OF RIGHT TO APPROPRIATE GROUND WATER

TO THE STATE ENGINEER OF OREGON:

I, CARL BREMER

of Pt. 2, Box 179, Woodborn County of CLACKAMAS
(Mailing address)

State of OREGON, do hereby make application for a certificate of registration as evidence of a right to appropriate ground water.

1. Source from which water is withdrawn is Pump Well
(Flowing well, pump well, infiltration trench, or tunnel)

2. Location is: 2 MILES NE OF MONITOR
(Approximate distance and direction from nearest city or town)

and is more particularly described as follows:

(a) S 58° 20' E, 3325' FROM NW CORNER OF SEC. 19
(Give distance and bearing to corner of section or other legal subdivision)

being within SW 1/4 NE 1/4 of Sec. 19, Twp. 5S, Rge. 1E
(Smallest legal subdivision) (N. or S.) (E. or W.)

or (b) within limits of recorded platted property, town or city:

in Lot , Block of
(Name of plat or addition)

(If within city or town, give name) County of

3. Construction Work was begun on Oct. 1949; was completed on Oct. 1949
(Date) (Date)

and the ground water claimed was first used for the purposes set out below on Nov. 1949
(Date)

since which time the water has been used Continuously
(Continuously or intermittently)

from Nov. 1949 to July 58
(Date) (Date)

4. Quantity of water claimed and used is 70 gal gallons per minute; unknown acre feet per year.

5. Purpose or Purposes for which water is used IRRIGATION

(Domestic, irrigation, municipal, manufacturing, industrial, etc.)

6. Description of Well: Depth 179 feet. Type Drilled
(Dug or drilled)

diameter 8 inches. Elevation of ground at well site 210 feet, mean sea level.
(As near as known)

Depth to water table 26 feet.

7. Capacity of Well: 70 g.p.m. with unknown feet drawdown.

 g.p.m. with feet drawdown.


Date of test 5/11/56

If Flowing Well: Measured discharge g.p.m. on
(Date)

Shut-in pressure at ground surface lbs. per sq. in. on
(Date)

Water is controlled by
(Cap, valve, etc.)

Township 55 Range 15 W.M.
North

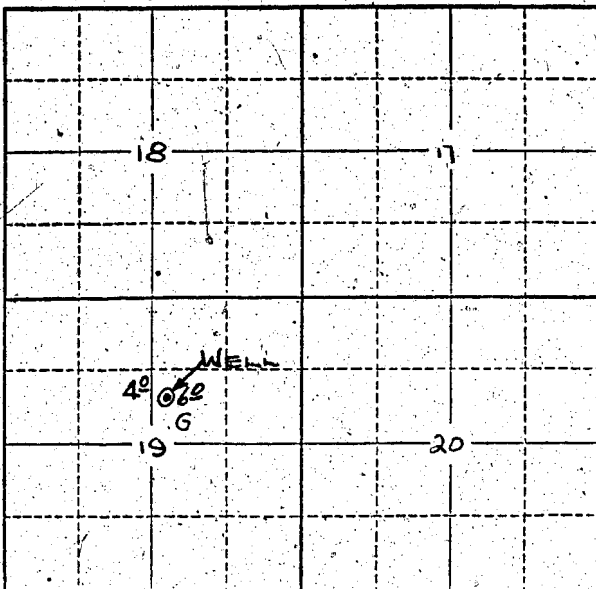

Locate well and acreage of irrigated land on plat.
Scale: 2" = 1 Mile

STATE OF OREGON

County of Clatsop } ss.

I, Earl P. Bruner being first duly sworn, do hereby certify that I have read the foregoing Registration Statement and that all of the items therein contained are true to the best of my knowledge and belief.

Earl P. Bruner
(Signature of Registrant)

Subscribed and sworn to before me this 28 day of July, 1958

My commission expires _____

Robert Schumacher
(Notary Public)

(SEAL)

Louise Hensch Deputy

CERTIFICATE OF REGISTRATION

STATE OF OREGON }
County of Marion } ss.

This is to certify that the foregoing Registration Statement was received in the office of the State Engineer on the 30th day of July, 1958, at 8:00 o'clock A. M. and has been duly recorded in said office in Book No. 12 of Registration Statements on page GR-2900

Witness my hand this 25th day of May, 1959

Lewis A. Stanley
(State Engineer)

By _____
(Deputy)

\$15.00