

RECEIVED
JUL 30 1958

Registration Statement

STATE ENGINEER
Salem, Oregon

OF CLAIMANT OF RIGHT TO APPROPRIATE GROUND WATER

TO THE STATE ENGINEER OF OREGON:

I, Nawley H. Kato
of Rt 1 Box 187, Gresham County of Mult.
(Mailing address)

State of Oregon, do hereby make application for a certificate of registration as evidence of a right to appropriate ground water.

1. Source from which water is withdrawn is Pump Well
(Flowing well, pump well, infiltration trench, or tunnel)
2. Location is: 2 miles south west of Gresham on Deas Road + 182nd
(Approximate distance and direction from nearest city or town)

and is more particularly described as follows:

(a) S 18° 00' W from NE cor. Sec 19, 1700'
(Give distance and bearing to corner of section or other legal subdivision)

being within SE 1/4 NE 1/4 of Sec. 16, Twp. 1 S, Rge. 3 E
(Smallest legal subdivision) (N. or S.) (E. or W.)

or (b) within limits of recorded platted property, town or city:

in Lot _____, Block _____ of _____
(Name of plat or addition)

County of _____
(If within city or town, give name)

3. Construction Work was begun on May 21, 1953; was completed on June 20, 1953
(Date) (Date)

and the ground water claimed was first used for the purposes set out below on July 1953
(Date)

since which time the water has been used Continuously Intermittently during
(Continuously or intermittently) June to Oct.
from JUNE to OCT
(Date) (Date)

4. Quantity of water claimed and used is 360 G.P.M. gallons per minute; 130 acre feet per year.

5. Purpose or Purposes for which water is used Irrigation of small fruits and vegetables
(Domestic, irrigation, municipal, manufacturing, industrial, etc.)

6. Description of Well: Depth 350 feet, Type drilled
(Dug or drilled)
diameter 10 inches. Elevation of ground at well site 350 feet, mean sea level.
(As near as known)
Depth to water table 90 feet.

7. Capacity of Well: 375 g.p.m. with 8.5 feet drawdown. 4 hrs.
500 g.p.m. with 1.20 feet drawdown. 6 hrs.

Date of test June 20, 1953

If Flowing Well: Measured discharge _____ g.p.m. on _____
(Date)

Shut-in pressure at ground surface _____ lbs. per sq. in. on _____
(Date)

Water is controlled by _____
(Cap, valve, etc.)

8. Casing: (Give diameter, commercial specifications and depth below ground surface of each casing size.)

10 inch diameter *298 ft. 4 inches standard new black steel pipe with drive shoe* from 0 to 298 feet
 inch diameter from to feet
 inch diameter from to feet
 inch diameter from to feet

Describe and show depth of shoe, plug, adapter, liner or other details: *unknown*

9. Perforated Casings or Screens:

4 Way star driven down 3/8 by 1 1/2" 240 from 110 to 120
(Number per foot and size of perforations, or describe screen)
 192 from 167 to 175
 192 from 232 to 240
 192 from 276 to 284

10. Log of Well: (Describe each stratum or formation clearly, indicate if water bearing, and give thickness and depth as indicated.)

MATERIAL	Thickness (Feet)	Depth to Bottom (Feet)
Top soil	4	4
Gray Clay	46	50
Cemented Gravel a little water at 100'	50 107	150
Gray Clay	6	163
Cemented gravel	10	173
Gravel & some water	3	176
Cemented Gravel	9	185
yellow Muddy sand	11	196
Cemented gravel	6	202
Gray sand	26	228
Water bearing gravel and a little sand	70	298
Blue Clay	7	305
Sandy yellow shale	13	318
Blue and Black shale	32	350

If log of well is not available, give name and address of driller.

11. Infiltration Trench: Covered or open

Dimensions: Length ft. Minimum depth ft. Maximum depth ft.

Bottom width ft. Discharge g.p.m. Date of test

12. Tunnel: Type of lining

Dimensions:
(Length, course, and cross sectional size)

Position of water bearing stratum with reference to portal of tunnel

Log of tunnel: (Preceding table for log of well may be used, if desired. Give footage from portal and character of materials, as pertinent.)

13. Pumping Equipment:

(a) Pump *Western Land Roller Turbine Oil Lub* Capacity *3.60* g.p.m.
(Make, type and size)


(b) Motor *Electric 60 horse power*
(Type and horsepower)

14. Location of area irrigated or to be irrigated, or place of use if for purposes other than irrigation.

Township North or South	Range E. or W. of Willamette Meridian	Section	Forty-acre Tract	Number Acres To Be Irrigated	Date of Reclamation
15	3E	17	SE 1/4 SW 1/4	1.0	July 1953
15	3E	19	NE 1/4 NE 1/4	1.0	July 1953
15	3E	20	NW 1/4 NW 1/4	2.0	July 1953
15	3E	17	SW 1/4 SW 1/4	2.6	July 1953
15	3E	17	SE 1/4 SW 1/4	6.4	July 1953
15	3E	19	NE 1/4 NE 1/4	18.3	July 1953
15	3E	19	SE 1/4 NE 1/4	4.4	July 1953
15	3E	20	NW 1/4 NW 1/4	26.3	July 1953
15	3E	20	SW 1/4 NW 1/4	1.0	July 1953
				<u>52.0</u>	

15. If the ground water supply is supplemental to an existing water supply, identification of any application for a permit, permit, certificate or adjudicated right to appropriate water made or held by the registrant.

Township 15 Range 3E, W.M.
North

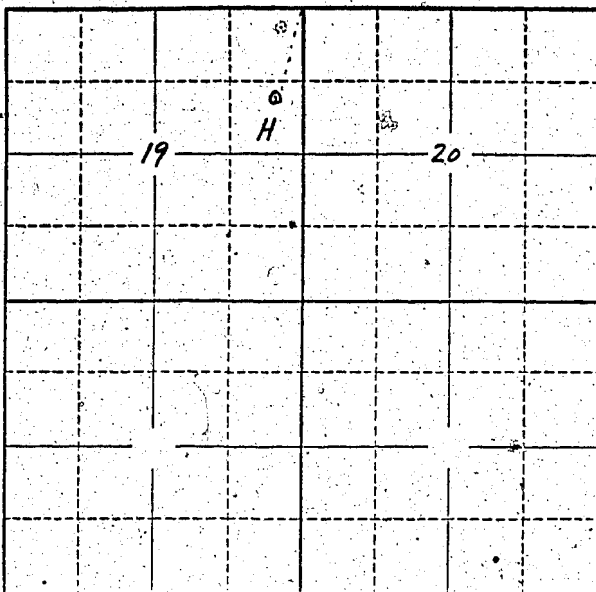

Locate well and acreage of irrigated land on plat.
Scale: 2" = 1 Mile

STATE OF OREGON

County of Multnomah } ss.

I, Stanley H. Kato, being first duly sworn, do hereby certify that I have read the foregoing Registration Statement and that all of the items therein contained are true to the best of my knowledge and belief.

Stanley H. Kato
(Signature of Registrant)

Subscribed and sworn to before me this 25th day of July, 1958.

My commission expires 7-10-59

Richard S. Hill
(Notary Public)

(SEAL)

CERTIFICATE OF REGISTRATION

STATE OF OREGON

County of Marion } ss.

This is to certify that the foregoing Registration Statement was received in the office of the State Engineer on the 30 day of July, 1958, at 8:00 o'clock A. M. and has been duly recorded in said office in Book No. 12 of Registration Statements on page GR-2906

Witness my hand this 25th day of May, 1959

Lewis A. Stanley
(State Engineer)

By _____
(Deputy)

GR-2906

18.30

18.30