

Registration Statement

OF CLAIMANT OF RIGHT TO APPROPRIATE GROUND WATER

TO THE STATE ENGINEER OF OREGON:

I, Gilbert C. Richardson
of 9700 S.E. Sunnyside Rd. Portland, Or. County of Clackamas
(Mailing address)

State of OREGON, do hereby make application for a certificate of registration as evidence of a right to appropriate ground water.

1. Source from which water is withdrawn is PUMP WELL
(Flowing well, pump well, infiltration trench, or tunnel)

2. Location is: Two Miles North East of Clackamas
(Approximate distance and direction from nearest city or town)

and is more particularly described as follows: 1290 feet west & 425 feet south from NE Corner Section 4

(a) South East Corner of Sunnyside - Stevens Road
(Give distance and bearing to corner of section or other legal subdivision)

being within NE 1/4 of NE 1/4 of Sec. 4, Twp. 2 S, Rge. 2 E W1
(Smallest legal subdivision) (N. or S.) (E. or W.)

or (b) within limits of recorded platted property, town or city: Clackamas

in Lot _____ Block _____ of William Matlock D.C.
(Name of plat or addition)

Clackamas County of Clackamas
(If within city or town, give name)

3. Construction Work was begun on Feb 4 1952; was completed on March 31 1952
(Date) (Date)

and the ground water claimed was first used for the purposes set out below on June 1952
(Date)

since which time the water has been used Continuously
(Continuously or Intermittently)

from June 1952 to July 1958 (Present Date)
(Date) (Date)

4. Quantity of water claimed and used is 70 gallons per minute; _____ acre feet per year.

5. Purpose or Purposes for which water is used Irrigation of Pasture, Stock Use
Supply water for water pans
(Domestic, irrigation, municipal, manufacturing, industrial, etc.)

6. Description of Well: Depth 22.5 feet. Type Drilled
(Dug or drilled)

diameter 8 inches. Elevation of ground at well site 2.50 ft feet, mean sea level.
(As near as known)

Depth to water table 8.5 feet. PUMPING LEVEL

7. Capacity of Well: 70 g.p.m. with 2.0 feet drawdown.

Net Test g.p.m. with _____ feet drawdown.


Date of test Tested with Baker & Miller

If Flowing Well: Measured discharge _____ g.p.m. on _____ (Date)

Shut-in pressure at ground surface _____ lbs. per sq. in. on _____ (Date)

Water is controlled by _____
(Cap, valve, etc.)

Township 29, Range 25, W.M.
North

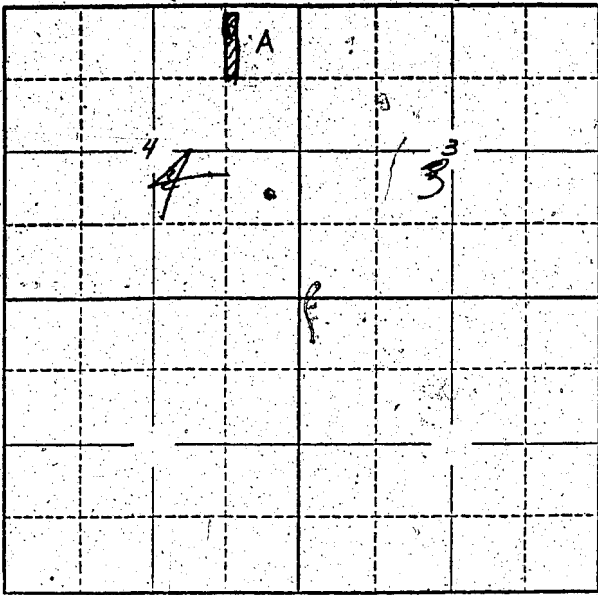

Locate well and acreage of irrigated land on plat.
Scale: 2" = 1 Mile

STATE OF OREGON

County of CLACKAMAS } ss.

I, Albert C. Richardson, being first duly sworn, do hereby certify that I have read the foregoing Registration Statement and that all of the items therein contained are true to the best of my knowledge and belief.

Albert C. Richardson
(Signature of Registrant)

Subscribed and sworn to before me this 29th day of July, 1958.

My commission expires November 9 1961

Shelley M. Hollberg
(Notary Public)

(SEAL)

CERTIFICATE OF REGISTRATION

STATE OF OREGON } ss.
County of Marion

This is to certify that the foregoing Registration Statement was received in the office of the State Engineer on the 30th day of July, 1958, at 8:00 o'clock A. M. and has been duly recorded in said office in Book No. 12 of Registration Statements on page GR-2909

Witness my hand this 25th day of May, 1959.

Lewis A. Stanley
(State Engineer)

By _____
(Deputy)

\$15.00