

# Registration Statement

## OF CLAIMANT OF RIGHT TO APPROPRIATE GROUND WATER

TO THE STATE ENGINEER OF OREGON:

I, Bernard and Eldred Schielder

of Rt 1 Box 128 Mt Angel County of Marion

(Mailing address)

State of Oregon, do hereby make application for a certificate of registration as evidence of a right to appropriate ground water.

1. Source from which water is withdrawn is pump well 3"  
(Flowing well, pump well, infiltration trench, or tunnel)

2. Location is: 2 miles south of Mt Angel  
(Approximate distance and direction from nearest city or town)

and is more particularly described as follows:

(a) 2190' S 72° 30' E from the NW Cor Sec 22 T6S R1W  
(Give distance and bearing to corner of section or other legal subdivision)

being within NE 1/4 of the NW 1/4 of Sec. 22, Twp. 6 S, Rge. 1 W  
(Smallest legal subdivision) (N. or S.) (E. or W.)

or (b) within limits of recorded platted property, town or city:

in Lot \_\_\_\_\_ Block \_\_\_\_\_ of \_\_\_\_\_  
(Name of plat or addition)

(If within city or town, give name)

County of \_\_\_\_\_

3. Construction Work was begun on Jan 1950; was completed on March 1950  
(Date) (Date)

and the ground water claimed was first used for the purposes set out below on Mar 1950  
(Date)

since which time the water has been used continuously  
(Continuously or intermittently)

from March 1950 to date  
(Date) (Date)

4. Quantity of water claimed and used is 150 gallons per minute; \_\_\_\_\_ acre feet per year.

5. Purpose or Purposes for which water is used irrigation

(Domestic, irrigation, municipal, manufacturing, industrial, etc.)

6. Description of Well: Depth 240 feet. Type drilled  
(Dug or drilled)

diameter 8 inches. Elevation of ground at well site 120 feet, mean sea level.  
(As near as known)

Depth to water table 18 feet.

7. Capacity of Well: 84 g.p.m. with 55 feet drawdown.

154 g.p.m. with 64 feet drawdown.

Date of test 6-30-58

If Flowing Well: Measured discharge \_\_\_\_\_ g.p.m. on \_\_\_\_\_  
(Date)


Shut-in pressure at ground surface \_\_\_\_\_ lbs. per sq. in. on \_\_\_\_\_  
(Date)

Water is controlled by \_\_\_\_\_  
(Cap, valve, etc.)





Township 65 Range 14, W.M.  
North

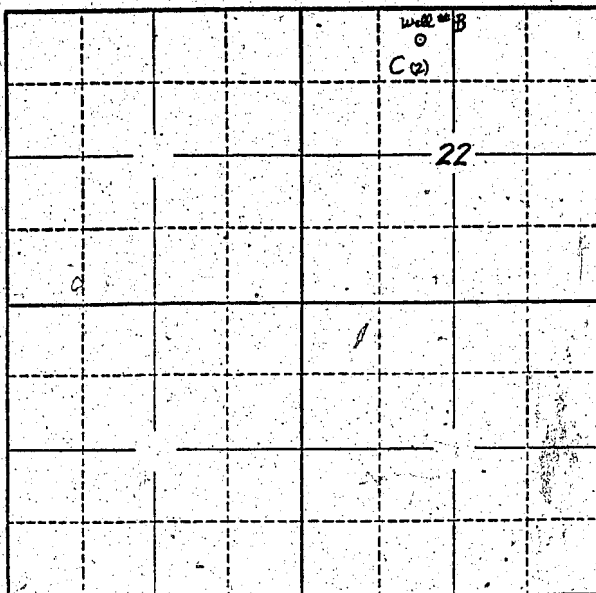

Locate well and acreage of irrigated land on plat.

Scale: 2" = 1 Mile

STATE OF OREGON

County of Marion

ss.

I, Bernard Schudler, being first duly sworn, do hereby certify that I have read the foregoing Registration Statement and that all of the items therein contained are true to the best of my knowledge and belief.

Bernard Schudler  
(Signature of Registrant)

Subscribed and sworn to before me this 30th day of July, 1958.

My commission expires 12th June 1961

Wm. S. Bartholmeas  
(Notary Public)

(SEAL)

**CERTIFICATE OF REGISTRATION**

STATE OF OREGON

County of Marion

ss.

This is to certify that the foregoing Registration Statement was received in the office of the State Engineer on the 30th day of July, 1958, at 10:30 o'clock A. M. and has been duly recorded in said office in Book No. 12 of Registration Statements on page GR-2912

Witness my hand this 25th day of May, 1959.

Laura A. Stanley  
(State Engineer)

By \_\_\_\_\_  
(Deputy)

\$18.30

GR - 2912