

# Registration Statement

## OF CLAIMANT OF RIGHT TO APPROPRIATE GROUND WATER

TO THE STATE ENGINEER OF OREGON:

I, Frank B. Krauger and Rose T. Krauger  
of Route 1, Box 18, Independence County of Polk  
(Mailing address)

State of Oregon, do hereby make application for a certificate of registration as evidence of a right to appropriate ground water.

1. Source from which water is withdrawn is Pump well  
(Flowing well, pump well, infiltration trench, or tunnel)

2. Location is: 2 miles south of Independence  
(Approximate distance and direction from nearest city or town)

and is more particularly described as follows:

(a) S 31° 50' E 920 feet from NW corner of Sec. 3 T 93 R 9 W  
(Give distance and bearing to corner of section or other legal subdivision)  
being within NW 1/4 of NW 1/4 of Sec. 3, Twp. 9 S, Rge. 9 W  
(Smallest legal subdivision) (N. or S.) (E. or W.)

or (b) within limits of recorded platted property, town or city:

in Lot \_\_\_\_\_, Block \_\_\_\_\_ of \_\_\_\_\_  
(Name of plat or addition)  
County of Polk  
(If within city or town, give name)

3. Construction Work was begun on 1943; was completed on 1943  
(Date) (Date)

and the ground water claimed was first used for the purposes set out below on 1943  
(Date)

since which time the water has been used continuously  
(Continuously or intermittently)

from 1943 to July 29, 1958  
(Date) (Date)

4. Quantity of water claimed and used is 210 gallons per minute; 44 acre feet per year.

5. Purpose or Purposes for which water is used \_\_\_\_\_

Irrigation  
(Domestic, irrigation, municipal, manufacturing, industrial, etc.)

6. Description of Well: Depth 35 feet. Type Drilled  
(Dug or drilled)

diameter 10 inches. Elevation of ground at well site \_\_\_\_\_ feet, mean sea level.  
(As near as known)

Depth to water table 24 feet.

7. Capacity of Well: \_\_\_\_\_ g.p.m. with 6 feet drawdown.

\_\_\_\_\_ g.p.m. with \_\_\_\_\_ feet drawdown.

Date of test \_\_\_\_\_

If Flowing Well: Measured discharge \_\_\_\_\_ g.p.m. on \_\_\_\_\_  
(Date)


Shut-in pressure at ground surface \_\_\_\_\_ lbs. per sq. in. on \_\_\_\_\_  
(Date)

Water is controlled by \_\_\_\_\_  
(Cap, valve, etc.)





Township 9E Range 4W W.M.  
North

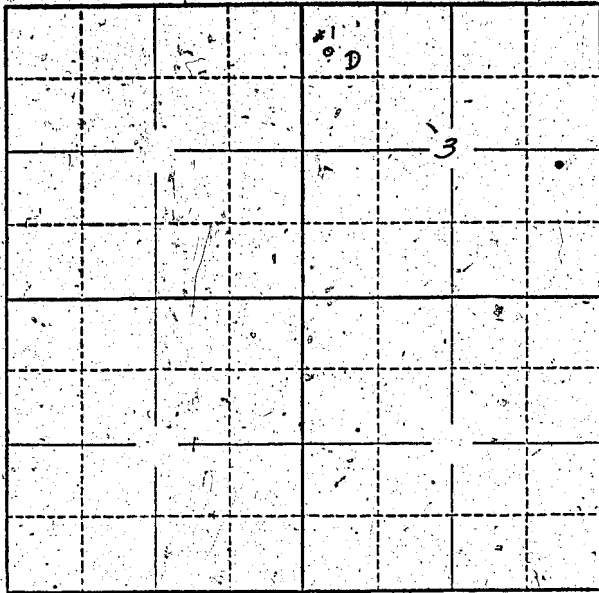

Locate well and acreage of irrigated land on plat.  
Scale: 2" = 1 Mile

STATE OF OREGON

County of \_\_\_\_\_ } ss.

I, Frank D. Thurgood, being first duly sworn, do hereby certify that I have read the foregoing Registration Statement and that all of the items therein contained are true to the best of my knowledge and belief.

Frank D. Thurgood  
(Signature of Registrant)

Subscribed and sworn to before me this 30th day of July, 1958.

My commission expires June 12th 1961 Wm. S. Bortolomeo  
(Notary Public)

(SEAL)

**CERTIFICATE OF REGISTRATION**

STATE OF OREGON

County of Marion } ss.

This is to certify that the foregoing Registration Statement was received in the office of the State Engineer on the 30th day of July, 1958, at 8:30 o'clock A.M. and has been duly recorded in said office in Book No. 12 of Registration Statements on page GR-2914

Witness my hand this 25th day of May, 1959

Lura A. Stanley  
(State Engineer)

By \_\_\_\_\_  
(Deputy)

\$ 15.00