

# Registration Statement

## OF CLAIMANT OF RIGHT TO APPROPRIATE GROUND WATER

TO THE STATE ENGINEER OF OREGON:

I, Gordon Walker for Dean Walker Farms

of 168 C Street Independence, Oregon County of Polk

(Mailing address)

State of Oregon, do hereby make application for a certificate of registration as evidence of a right to appropriate ground water.

1. Source from which water is withdrawn is Pump well  
(Flowing well, pump well, infiltration trench, or tunnel)

2. Location is: Young Ranch, 5 miles north of Independence  
(Approximate distance and direction from nearest city or town)

and is more particularly described as follows:

(a) 2204' west and 25' south from NE. corner Bethuel Dove Claim No. 54  
(Give distance and bearing to corner of section or other legal subdivision)

being within NE 1/4 of SW 1/4 of of Sec. 35, Twp. 7 S., Rge. 4 W.  
(Smallest legal subdivision) (N. or S.) (E. or W.)

or (b) within limits of recorded platted property, town or city:

in Lot \_\_\_\_\_, Block \_\_\_\_\_ of \_\_\_\_\_  
(Name of plat or addition)

County of \_\_\_\_\_  
(If within city or town, give name)

3. Construction Work was begun on May 1953; was completed on May 1953  
(Date) (Date)

and the ground water claimed was first used for the purposes set out below on June 10, 1953  
(Date)

since which time the water has been used Seasonally  
(Continuously or Intermittently)

from June 10, 1953 to present (7-29-58)  
(Date) (Date)

4. Quantity of water claimed and used is 550 gallons per minute; \_\_\_\_\_ acre feet per year.

5. Purpose or Purposes for which water is used irrigation

(Domestic, irrigation, municipal, manufacturing, industrial, etc.)

6. Description of Well: Depth 40' feet. Type drilled

(Dug or drilled)

diameter 12" inches. Elevation of ground at well site 140 feet, mean sea level.  
(As near as known)

Depth to water table 22 feet.

7. Capacity of Well: 550 g.p.m. with 12' feet drawdown.

\_\_\_\_\_ g.p.m. with \_\_\_\_\_ feet drawdown.

8. Date of test 1959

If Flowing Well: Measured discharge \_\_\_\_\_ g.p.m. on \_\_\_\_\_  
(Date)

Shut-in pressure at ground surface \_\_\_\_\_ lbs. per sq. in. on \_\_\_\_\_  
(Date)

Water is controlled by \_\_\_\_\_  
(Cap, valve, etc.)

8. Casing: (Give diameter, commercial specifications and depth below ground surface of each casing size.)

12" inch diameter standard well casing from 0 to 40 feet  
 \_\_\_\_\_ inch diameter \_\_\_\_\_ from \_\_\_\_\_ to \_\_\_\_\_ feet  
 \_\_\_\_\_ inch diameter \_\_\_\_\_ from \_\_\_\_\_ to \_\_\_\_\_ feet  
 \_\_\_\_\_ inch diameter \_\_\_\_\_ from \_\_\_\_\_ to \_\_\_\_\_ feet

Describe and show depth of shoe, plug, adapter, liner or other details: none

9. Perforated Casings or Screens:

9  $\frac{1}{2}$ " x 4" from 30 to 40  
 (Number per foot and size of perforations, or describe screen)  
 \_\_\_\_\_ from \_\_\_\_\_ to \_\_\_\_\_  
 \_\_\_\_\_ from \_\_\_\_\_ to \_\_\_\_\_  
 \_\_\_\_\_ from \_\_\_\_\_ to \_\_\_\_\_

10. Log of Well: (Describe each stratum or formation clearly, indicate if water bearing, and give thickness and depth as indicated.)

MATERIAL	Thickness (Feet)	Depth to Bottom (Feet)
No log kept.		

11. Infiltration Trench: Covered or open .....

Dimensions: Length ..... ft. Minimum depth ..... ft. Maximum depth ..... ft.

Bottom width ..... ft. Discharge ..... g.p.m. Date of test .....

12. Tunnel: Type of lining .....

Dimensions: .....  
(Length, course, and cross sectional size)

Position of water bearing stratum with reference to portal of tunnel .....

Log of tunnel: (Preceding table for log of well may be used, if desired. Give footage from portal and character of materials, as pertinent.)

13. Pumping Equipment:

(a) Pump 4x5 Pacific ..... Capacity 600 ..... g.p.m.  
(Make, type and size)

(b) Motor 30 hp close coupled electric .....  
(Type and horsepower)


14. Location of area irrigated or to be irrigated, or place of use if for purposes other than irrigation.

Township North or South	Range E. or W. of Willamette Meridian	Section	Forty-acre Tract	Number Acres To Be Irrigated	Date of Reclamation
7 South	4 West	35	NW 1/4 of SW 1/4	11.50	6-10-53
7 South	4 West	35	NE 1/4 of SW 1/4	10.50	6-10-53
7 South	4 West	35	SW 1/4 of SW 1/4	33.50	6-10-53
7 South	4 West	35	SE 1/4 of SW 1/4	24.50	6-10-53
8 South	4 West	2	NW 1/4 of NW 1/4	9.00	6-10-53
8 South	4 west	2	NE 1/4 of NW 1/4	6.00	6-10-53
				<u>95.00 Ac</u>	

15. If the ground water supply is supplemental to an existing water supply, identification of any application for a permit, permit, certificate or adjudicated right to appropriate water made or held by the registrant.

No

Township 7S Range 4W W.M.  
North

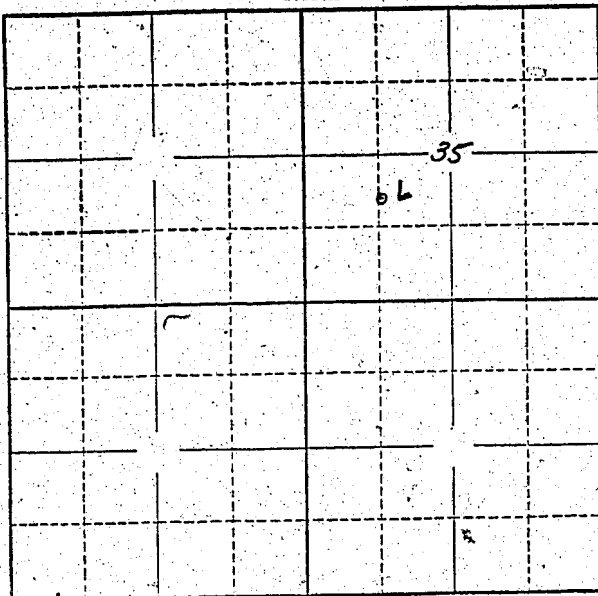

Locate well and acreage of irrigated land on plat.  
Scale: 2" = 1 Mile

STATE OF OREGON

County of Clatsop

} ss.

I, Gordon Walker, being first duly sworn, do hereby certify that I have read the foregoing Registration Statement and that all of the items therein contained are true to the best of my knowledge and belief.

Gordon Walker  
(Signature of Registrant)

Subscribed and sworn to before me this 29<sup>th</sup> day of July, 1958

My commission expires Nov 13, 1961

Quinn Dennis  
(Notary Public)

(SEAL)

**CERTIFICATE OF REGISTRATION**

STATE OF OREGON

County of Marion

} ss.

This is to certify that the foregoing Registration Statement was received in the office of the State Engineer on the 30<sup>th</sup> day of July, 1958, at 10:55 o'clock A.M. and has been duly recorded in said office in Book No. 12 of Registration Statements on page GR-2918

Witness my hand this 25<sup>th</sup> day of May, 1959

Laura G. Stanley  
(State Engineer)

By \_\_\_\_\_ (Deputy)

# 24.75