

# Registration Statement

## OF CLAIMANT OF RIGHT TO APPROPRIATE GROUND WATER

TO THE STATE ENGINEER OF OREGON:

I, Knight Percy  
of PO box 12 Salem ore County of Marion  
(Mailing address)

State of Oregon, do hereby make application for a certificate of registration as evidence of a right to appropriate ground water.

1. Source from which water is withdrawn is pump well #2  
(Flowing well, pump well, infiltration trench, or tunnel)
2. Location is: 5 miles north of Salem city limity adjacent to Pacific hwy. 99E  
(Approximate distance and direction from nearest city or town)

and is more particularly described as follows:

(a) 1020' West & 370' south of 1/4 section corner  
(Give distance and bearing to corner of section or other legal subdivision)

being within NW 1/4 of SW 1/4 of Sec. 20, Twp. S, Rge. 2W  
(Smallest legal subdivision) (N, S, E, or W)

or (b) within limits of recorded platted property, town or city:

in Lot \_\_\_\_\_, Block \_\_\_\_\_ of \_\_\_\_\_  
(Name of plat or addition)

County of MARION  
(If within city or town, give name)

3. Construction Work was begun on May 1940; was completed on May 1940  
(Date) (Date)

and the ground water claimed was first used for the purposes set out below on June 15, 1940,  
(Date)

since which time the water has been used continually  
(Continuously or Intermittently)

from June 15, 1940 to July 29, 1958  
(Date) (Date)

4. Quantity of water claimed and used is 30 gal gallons per minute; 3.5 acre feet per year.

5. Purpose or Purposes for which water is used Irrigation

(Domestic, irrigation, municipal, manufacturing, industrial, etc.)

6. Description of Well: Depth 92 feet. Type drilled  
(Dug or drilled)

diameter 6" inches. Elevation of ground at well site 185 feet, mean sea level.  
(As near as known)

Depth to water table 28 ft feet.

7. Capacity of Well: 30 gal g.p.m. with \_\_\_\_\_ feet drawdown.

\_\_\_\_\_ g.p.m. with \_\_\_\_\_ feet drawdown.

Date of test no test

If Flowing Well: Measured discharge \_\_\_\_\_ g.p.m. on \_\_\_\_\_  
(Date)

Spout-in pressure at ground surface \_\_\_\_\_ lbs. per sq. in. on \_\_\_\_\_  
(Date)

Water is controlled by \_\_\_\_\_  
(Cap, valve, etc.)



If log of well is not available, give name and address of driller.

Sneed and son Salem ore

11. Infiltration Trench: Covered or open

Dimensions: Length ft. Minimum depth ft. Maximum depth ft.

Bottom width ft. Discharge g.p.m. Date of test

12. Tunnel: Type of lining

Dimensions: (Length, course, and cross sectional size)

Position of water bearing stratum with reference to portal of tunnel

Log of tunnel: (Preceding table for log of well may be used, if desired. Give footage from portal and character of materials, as pertinent.)

13. Pumping Equipment:

(a) Pump 3 H.P. Jet Capacity 35 g.p.m.

(Make, type and size)

(b) Motor 3 H.P. Electric (Type and horsepower)


14. Location of area irrigated or to be irrigated, or place of use if for purposes other than irrigation.

Township North or South	Range E. or W. of Willamette Meridian	Section	Forty-acre Tract	Number Acres To Be Irrigated	Date of Reclamation
65	2W	20	NW 1/4 of SW 1/4	14.6	1940
65	2W	20	NE 1/4 of SW 1/4	2.9	1940
			Total	17.5	"

15. If the ground water supply is supplemental to an existing water supply, identification of any application for a permit, permit, certificate or adjudicated right to appropriate water made or held by the registrant.

None

Township 6S Range 2W, W.M.  
North

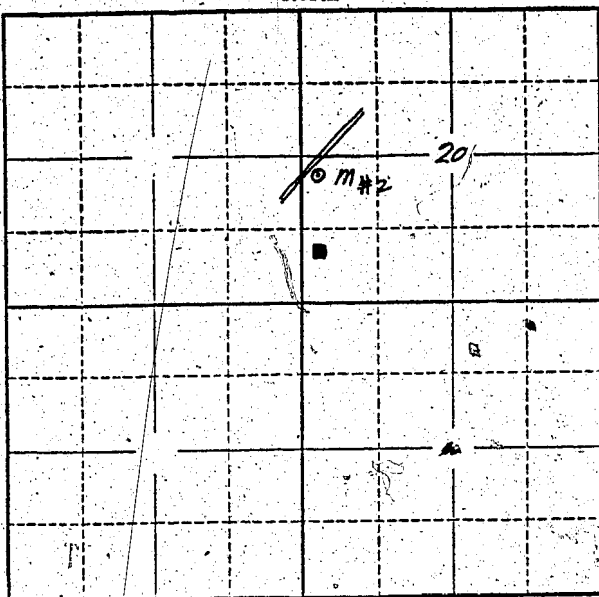

Locate well and acreage of irrigated land on plat.

Scale: 2" = 1 Mile

STATE OF OREGON

County of Marion

} ss.

I, \_\_\_\_\_, being first duly sworn, do hereby certify that I have read the foregoing Registration Statement and that all of the items therein contained are true to the best of my knowledge and belief.

[Signature]  
(Signature of Registrant)

Subscribed and sworn to before me this 30 day of July, 1958

My commission expires Nov. 23, 1958

[Signature]  
(Notary Public)

(SEAL)

**CERTIFICATE OF REGISTRATION**

STATE OF OREGON

County of Marion

} ss.

This is to certify that the foregoing Registration Statement was received in the office of the State Engineer on the 30th day of July, 1958, at 10:30 o'clock A. M. and has been duly recorded in said office in Book No. 12 of Registration Statements on page GR-2920

Witness my hand this 25th day of May, 1959

[Signature]  
(State Engineer)

By \_\_\_\_\_

(Deputy)

GR-2920

\$15.00