

# Registration Statement

## OF CLAIMANT OF RIGHT TO APPROPRIATE GROUND WATER

TO THE STATE ENGINEER OF OREGON:

I, Harry J. Duncan  
of 1685 Harmony Drive Salem County of Marion  
(Mailing address)

State of Oregon, do hereby make application for a certificate of registration as evidence of a right to appropriate ground water.

- 1. Source from which water is withdrawn is Pump well  
(Flowing well, pump well, infiltration trench, or tunnel)
- 2. Location is: 1/2 miles North of Kiezor  
(Approximate distance and direction from nearest city or town)

and is more particularly described as follows:

(a) 200' North & 50' west of N.E. Corner Sect 35  
(Give distance and bearing to corner of section or other legal subdivision)  
being within SE 1/4 of NE 1/4 of Sec. 35, Twp. 6S, Rge. 3W  
(Smallest legal subdivision) (S. or S.) (E. or W.)

or (b) within limits of recorded platted property, town or city:  
in Lot \_\_\_\_\_ Block \_\_\_\_\_ of \_\_\_\_\_  
(Name of plat or addition)

County of \_\_\_\_\_  
(If within city or town, give name)

3. Construction Work was begun on 7-16-52; was completed on 9-16-52  
(Date) (Date)

and the ground water claimed was first used for the purposes set out below on 9-16-52,  
since which time the water has been used intermittently  
(Continuously or intermittently)  
from 9-16-52 to date  
(Date) (Date)

4. Quantity of water claimed and used is 290 gallons per minute; \_\_\_\_\_ acre feet per year.

5. Purpose or Purposes for which water is used Irrigation  
(Domestic, irrigation, municipal, manufacturing, industrial, etc.)

6. Description of Well: Depth 41' feet. Type Drilled  
(Dug or drilled)  
diameter 8 inches. Elevation of ground at well-site \_\_\_\_\_ feet, mean sea level.  
(As near as known)  
Depth to water table 25 feet.

7. Capacity of Well: 240 g.p.m. with 14 feet drawdown.  
\_\_\_\_\_ g.p.m. with \_\_\_\_\_ feet drawdown.

Date of test 9/17/52

If Flowing Well: Measured discharge \_\_\_\_\_ g.p.m. on \_\_\_\_\_  
(Date)

Shut-in pressure at ground surface \_\_\_\_\_ lbs. per sq. in. on \_\_\_\_\_  
(Date)

Water is controlled by \_\_\_\_\_  
(Cap, valve, etc.)

8. Casing: (Give diameter, commercial specifications and depth below ground surface of each casing size.)

8 inch diameter ..... from 0 to 411 feet  
 inch diameter ..... from ..... to ..... feet  
 inch diameter ..... from ..... to ..... feet  
 inch diameter ..... from ..... to ..... feet

Describe and show depth of shoe, plug, adapter, liner or other details: .....  
 .....  
 .....

9. Perforated Casings or Screens:

No data ..... from 30 to 410  
 (Number per foot and size of perforations, or describe screen) :  
 ..... from ..... to .....  
 ..... from ..... to .....  
 ..... from ..... to .....

10. Log of Well: (Describe each stratum or formation clearly, indicate if water bearing, and give thickness and depth as indicated.)

MATERIAL	Thickness (Feet)	Depth to Bottom (Feet)

If log of well is not available, give name and address of driller. ....

11. Infiltration Trench: Covered or open .....

Dimensions: Length ..... ft. Minimum depth ..... ft. Maximum depth ..... ft.

Bottom width ..... ft. Discharge ..... g.p.m. Date of test .....

12. Tunnel: Type of lining .....

Dimensions: .....  
(Length, course, and cross sectional size)

Position of water bearing stratum with reference to portal of tunnel .....

Log of tunnel: (Preceding table for log of well may be used, if desired. Give footage from portal and character of materials, as pertinent.)

13. Pumping Equipment:

(a) Pump 5 H.P. Ber. Kelly Capacity 90 g.p.m.  
(Make, type, and size)


(b) Motor Twin Line 5 H.P.  
(Type and horsepower)

14. Location of area irrigated or to be irrigated, or place of use if for purposes other than irrigation.

Township North or South	Range E. or W. of Willametta Meridian	Section	Forty-acre Tract	Number Acres To Be Irrigated	Date of Reclamation
T6S	R3W	35	SE $\frac{1}{4}$ of NE $\frac{1}{4}$	12. <sup>0</sup>	1952
T6S	R3W	316	SW $\frac{1}{4}$ of NW $\frac{1}{4}$	13. <sup>0</sup>	1952
				<u>25.<sup>0</sup></u>	

15. If the ground water supply is supplemental to an existing water supply, identification of any application for a permit, permit, certificate or adjudicated right to appropriate water made or held by the registrant.

Township 6S Range 3W, W.M.  
North

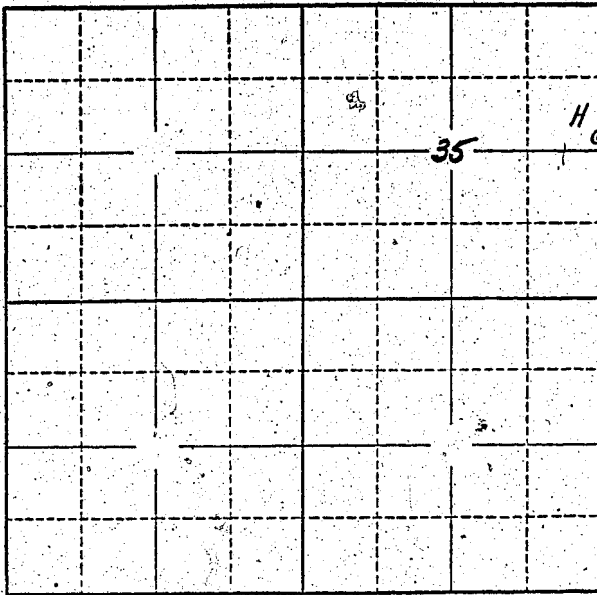

Locate well and acreage of irrigated land on plat.  
Scale: 2" = 1 Mile

STATE OF OREGON

County of Marion } ss.

I, Harry Duncan, being first duly sworn, do hereby certify that I have read the foregoing Registration Statement and that all of the items therein contained are true to the best of my knowledge and belief.

Harry Duncan  
(Signature of Registrant)

Subscribed and sworn to before me this 30th day of July, 1958

My commission expires 12th June 1961 Wm S. Bartholomew  
(Notary Public)

(SEAL)

**CERTIFICATE OF REGISTRATION**

STATE OF OREGON

County of Marion } ss.

This is to certify that the foregoing Registration Statement was received in the office of the State Engineer on the 30th day of July, 1958, at 11:29 o'clock A. M. and has been duly recorded in said office in Book No. 12 of Registration Statements on page GR-2921

Witness my hand this 25th day of May, 1959

Lewis A. Stanley  
(State Engineer)

By \_\_\_\_\_ (Deputy)

\$15.00