

Registration Statement

OF CLAIMANT OF RIGHT TO APPROPRIATE GROUND WATER

TO THE STATE ENGINEER OF OREGON:

I, J. A. RICKARD
of Rt. 1 Box 260 County of Marion
(Mailing address)

State of Oregon, do hereby make application for a certificate of registration as evidence of a right to appropriate ground water.

- 1. Source from which water is withdrawn is Pump Well
(Flowing well, pump well, infiltration trench, or tunnel)
- 2. Location is: 2 miles south of Brooks
(Approximate distance and direction from nearest city or town)

and is more particularly described as follows:

(a) 29 Ch. N. & 5 E Ch. W. from S 1/4 Corner S. 29
(Give distance and bearing to corner of section or other legal subdivision)
being within N. E. 1/4 S. W. 1/4 of Sec. 29, Twp. 6 S., Rge. 2 W.
(Smallest legal subdivision) (N. or S.) (E. or W.)

or (b) within limits of recorded platted property, town or city: _____
in Lot _____, Block _____ of _____
(Name of plat or addition)

County of _____
(If within city or town, give name)

3. Construction Work was begun on Mar. 1938; was completed on Mar. 1938
(Date) (Date)
and the ground water claimed was first used for the purposes set out below on Mar. 1938
(Date)
since which time the water has been used During Irrigation Season
(Continuously or Intermittently)
from 1938 to Present
(Date) (Date)

4. Quantity of water claimed and used is 420 gallons per minute; 35 acre feet per year.

5. Purpose or Purposes for which water is used Irrigation
(Domestic, irrigation, municipal, manufacturing, industrial, etc.)

6. Description of Well: Depth 60 feet. Type Drilled
(Dug or drilled)
diameter 8 inches. Elevation of ground at well site 175 feet, mean sea level.
(As near as known)
Depth to water table 4 feet.

7. Capacity of Well: 500 g.p.m. with 2 feet drawdown.
1 g.p.m. with _____ feet drawdown.
Date of test 1938

If Flowing Well: Measured discharge _____ g.p.m. on _____
(Date)

Shut-in pressure at ground surface _____ lbs. per sq. in. on _____
(Date)

Water is controlled by _____
(Cap, valve, etc.)

8. Casing: (Give diameter, commercial specifications and depth below ground surface of each casing size.)

8 inch diameter from *Top* to *6.0* feet
..... inch diameter from to *bottom* feet
..... inch diameter from to feet
..... inch diameter from to feet

Describe and show depth of shoe, plug, adapter, liner or other details:

9. Perforated Casings or Screens:

details unknown from to
(Number per foot and size of perforations, or describe screen)
..... from to
..... from to
..... from to

10. Log of Well: (Describe each stratum or formation clearly, indicate if water bearing, and give thickness and depth as indicated.)

MATERIAL	Thickness (Feet)	Depth to Bottom (Feet)
<i>not available</i>		

If log of well is not available, give name and address of driller. *not known*

11. Infiltration Trench: Covered or open

Dimensions: Length ft. Minimum depth ft. Maximum depth ft.

Bottom width ft. Discharge g.p.m. Date of test

12. Tunnel: Type of lining

Dimensions: (Length, course, and cross sectional size)

Position of water bearing stratum with reference to portal of tunnel

Log of tunnel: (Preceding table for log of well may be used, if desired. Give footage from portal and character of materials, as pertinent.)

13. Pumping Equipment:

(a) Pump *Soulds 1 1/2" Centrifugal* Capacity *130* g.p.m.
(Make, type and size)


(b) Motor *Westinghouse 5 H.P.*
(Type and horsepower)

14. Location of area irrigated or to be irrigated, or place of use if for purposes other than irrigation.

Township North or South	Range E. or W. of Williams's Meridian	Section	Forty-acre Tract	Number Acres To Be Irrigated	Date of Reclamation
<i>6 S</i>	<i>2 W.</i>	<i>29</i>	<i>N.E. 1/4 SW 1/4</i>	<i>112</i>	<i>1938</i>
<i>"</i>	<i>"</i>	<i>"</i>	<i>SE 1/4 NW 1/4</i>	<i>28</i>	<i>"</i>
				<i>140</i>	<i>"</i>

15. If the ground water supply is supplemental to an existing water supply, identification of any application for a permit, permit, certificate or adjudicated right to appropriate water made or held by the registrant.

Township 6 S Range 2 W, W.M.
North

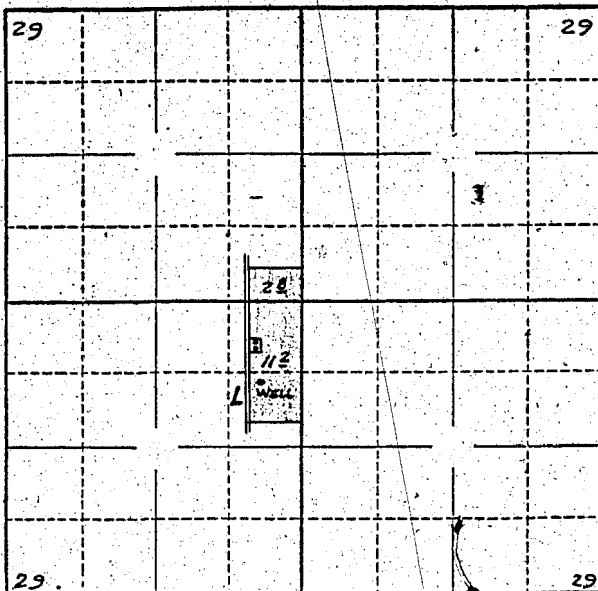

Locate well and acreage of irrigated land on plat.

Scale: $\frac{1}{4}$ " = 1 Mile

STATE OF OREGON

County of Marion } ss.

I, J. L. Rickard, being first duly sworn, do hereby certify that I have read the foregoing Registration Statement and that all of the items therein contained are true to the best of my knowledge and belief.

J. L. Rickard
(Signature of Registrant)

Subscribed and sworn to before me this 30th day of July, 1958.

My commission expires 9/27/58

Jeanne Baxter
(Notary Public)

(SEAL)

CERTIFICATE OF REGISTRATION

STATE OF OREGON

County of Marion } ss.

This is to certify that the foregoing Registration Statement was received in the office of the State Engineer on the 30th day of July, 1958, at 11:15 o'clock A.M. and has been duly recorded in said office in Book No. 12 of Registration Statements on page GR-2922

Witness my hand this 25th day of May, 1959

Laura A. Stanley
(State Engineer)

By _____ (Deputy)

\$15.00

GR-2922