

Registration Statement

REGISTRATION NO. GR-3115

CERTIFICATE NO. GR-2923

OF CLAIMANT OF RIGHT TO APPROPRIATE GROUND WATER

(Under Chapter 708, Oregon Laws 1955.)

RECEIVED
STATE ENGINEER
SALEM, OREGON

TO THE STATE ENGINEER OF OREGON:

I, Clarence D. Van
of Silverton, Oregon County of Marion
State of Oregon, do hereby make application for a certificate of registration as evidence
of a right to appropriate ground water.

1. Source from which water is withdrawn is Pump Well
(Flowing well, pump well, infiltration trench, or trench)

2. Location is: 4 miles West & 1/4 mi. N. of Silverton
(Approximate distance and direction from nearest city or town)

and is more particularly described as follows:

(a) 750' E. & 290' N. of 1/4 sect. Corner (SW Corner of NW 1/4 of NW 1/4 - Sec. 6)
(Give distance and bearing to corner of section or other legal subdivision)
being within NW 1/4 of NW 1/4 of Sec. 6, Twp. 7 S Rge. 1 W
(Smallest legal subdivision) (N. or S.) (E. or W.)

or (b) within limits of recorded platted property, town or city:

in Lot _____, Block _____ of _____
(Name of plat or addition)

County of MARION
(If within city or town, give name)

3. Construction Work was begun on Feb. 1952; was completed on MARCH 1952
(Date) (Date)

and the ground water claimed was first used for the purposes set out below on MAY 1952
(Date)

since which time the water has been used Continuously
(Continuously or Intermittently)

from 1952 to 1958
(Date) (Date)

4. Quantity of water claimed and used is 400 gallons per minute; 163 acre
feet per year.

5. Purpose or Purposes for which water is used Irrigation - Beans - Clover
Beets
(Domestic, irrigation, municipal, manufacturing, industrial, etc.)

6. Description of Well: Depth 141 feet. Type Drilled
(Dug or drilled)

diameter 8" inches. Elevation of ground at well site _____ feet, mean sea level.
(As near as known)

Depth to water table 60 feet.

7. Capacity of Well: 500 g.p.m. with 30 feet drawdown.

_____ g.p.m. with _____ feet drawdown.

Date of test March 1952

If Flowing Well: Measured discharge _____ g.p.m. on _____
(Date)

Shut-in pressure at ground surface _____ lbs. per sq. in. on _____
(Date)

Water is controlled by _____
(Cap, valve, etc.)



8. **Casing:** (Give diameter, commercial specifications and depth below ground surface of each casing size.)

8 inch diameter from 0 to 141 feet
inch diameter from to feet
inch diameter from to feet
inch diameter from to feet

Describe and show depth of shoe, plug, adapter, liner or other details:
.....
.....

9. **Perforated Casings or Screens:**

..... from to
(Number per foot and size of perforations, or describe screen)
Not Known from to
..... from to
..... from to

10. **Log of Well:** (Describe each stratum or formation clearly, indicate if water bearing, and give thickness and depth as indicated.)

MATERIAL	Thickness (Feet)	Depth to Bottom (Feet)
Not Available		

If log of well is not available, give name and address of driller. Stadley - Silverson

11. Infiltration Trench: Covered or open

Dimensions: Length ft. Minimum depth ft. Maximum depth ft.

Bottom width ft. Discharge g.p.m. Date of test

12. Tunnel: Type of lining IV

Dimensions:
(Length, course, and cross sectional size)

Position of water bearing stratum with reference to portal of tunnel

Log of tunnel: (Preceding table for log of well may be used, if desired. Give footage from portal and character of materials, as pertinent.)

13. Pumping Equipment:

(a) Pump Barkley Turbine 40 H.P. Capacity 500 g.p.m.
(Make, type and site)

(b) Motor Electric 40 H.P.
(Type and horsepower)


14. Location of area irrigated or to be irrigated, or place of use if for purposes other than irrigation.

Township North or South	Range E. or W. of Willamette Meridian	Section	Forty-acre Tract	Number Acres To Be Irrigated	Date of Reclamation
7.5	1W	6	NW 1/4 of NW 1/4	23.3	1952
"	"	"	SW 1/4 of NW 1/4	12.2	1952
"	"	"	NE 1/4 of NW 1/4	18.4	1952
"	"	"	NW 1/4 of NE 1/4	11.3	1952
				<u>65.2</u> Ac	"

15. If the ground water supply is supplemental to an existing water supply, identification of any application for a permit, permit, certificate or adjudicated right to appropriate water made or held by the registrant.

Township 75 Range 14 W.M.

North

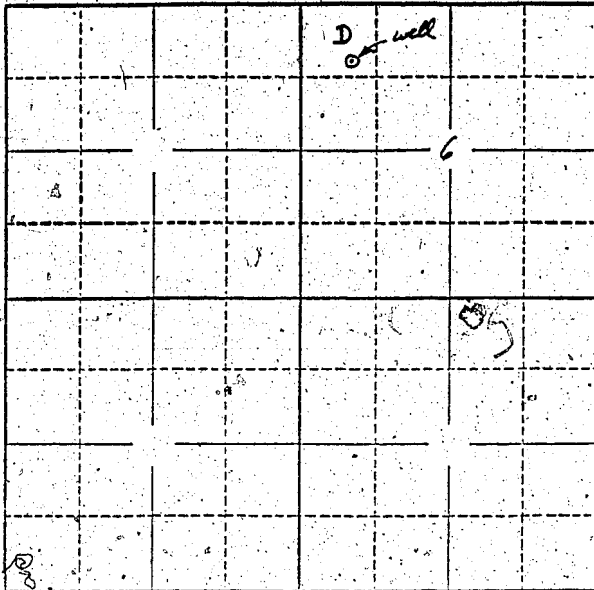

Locate well and acreage of irrigated land on plat.
Scale: 2" = 1 Mile

STATE OF OREGON

County of Marion } ss.

I, Clarence D. Herr, being first duly sworn, do hereby certify that I have read the foregoing Registration Statement and that all of the items therein contained are true to the best of my knowledge and belief.

Clarence D. Herr
(Signature of Registrant)

Subscribed and sworn to before me this 30 day of July, 1958

My commission expires April 26, 1960
Arthur J. Lane
(Notary Public)

(SEAL)

CERTIFICATE OF REGISTRATION

STATE OF OREGON

County of Marion } ss.

This is to certify that the foregoing Registration Statement was received in the office of the State Engineer on the 30th day of July, 1958, at 11:10 o'clock A. M. and has been duly recorded in said office in Book No. 12 of Registration Statements on page GR-2923

~~xx This certificate shall be completed by _____ and the state completely applied to _____~~

Witness my hand this 25th day of May, 1959

Lewis A. Stanley
(State Engineer)

By _____
(Deputy)

GR-2923

#20.40