

Registration Statement

REGISTRATION NO. GR-3116
CERTIFICATE NO. GR-2924

OF CLAIMANT OF RIGHT TO APPROPRIATE GROUND WATER

(Under Chapter 708, Oregon Laws 1955.)

RECEIVED
1950
STATE ENGINEER
SALES
NO. 1090

TO THE STATE ENGINEER OF OREGON:

I, Charles D. Herr
of Silverton Rt. 2 Box 187 County of Marion
State of Oregon, do hereby make application for a certificate of registration as evidence of a right to appropriate ground water.

1. Source from which water is withdrawn is Pump Well
(Flowing well, pump well, infiltration trench, or tunnel)

2. Location is: 4 miles west & 1/4 mile North of Silverton
(Approximate distance and direction from nearest city or town)

and is more particularly described as follows: (NE 1/4 corner of SE 1/4 of NE 1/4)

(a) 250' North & 470' West of 1/4 section corner
(Give distance and bearing to corner of section or other legal subdivision)

being within NE 1/4 of NE 1/4 of Sec. 1, Twp. 6 S Rge. 2 W
(Smallest legal subdivision) (N. or S.) (E. or W.)

or (b) within limits of recorded platted property, town or city:

in Lot _____, Block _____ of _____
(Name of plat or addition)

County of Marion
(If within city or town, give name)

3. Construction Work was begun on Jan. 1949; was completed on March 1949
(Date) (Date)

and the ground water claimed was first used for the purposes set out below on May 1949
(Date)

since which time the water has been used Continuously
(Continuously or intermittently)

from May 1949 to 1958
(Date) (Date)

4. Quantity of water claimed and used is 300 gallons per minute; 87 acre feet per year.

5. Purpose or Purposes for which water is used: Irrigation of Beans, Beets, Corn, etc.
(Domestic, irrigation, municipal, manufacturing, industrial, etc.)

6. Description of Well: Depth 131 feet. Type Drilled
(Dug or drilled)

diameter 10 inches. Elevation of ground at well site _____ feet, mean sea level.
(As near as known)

Depth to water table 60 feet.

7. Capacity of Well: 300 g.p.m. with 10.05 feet drawdown.

_____ g.p.m. with _____ feet drawdown.

Date of test March 1949

If Flowing Well: Measured discharge _____ g.p.m. on _____
(Date)

Shut-in pressure at ground surface _____ lbs. per sq. in. on _____
(Date)


Water is controlled by _____
(Cap, valve, etc.)

8. Casing: (Give diameter, commercial specifications and depth below ground surface of each casing size.)

10 inch diameter from 0 to 131 feet
inch diameter from to feet
inch diameter from to feet
inch diameter from to feet

Describe and show depth of shoe, plug, adapter, liner or other details:

9. Perforated Casings or Screens:

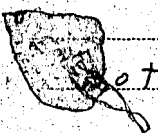 (Number per foot and size of perforations, or describe screen) from to
Not known from to
from to
from to

10. Log of Well: (Describe each stratum or formation clearly, indicate if water bearing, and give thickness and depth as indicated.)

MATERIAL	Thickness (Feet)	Depth to Bottom (Feet)
Not Available		

If log of well is not available, give name and address of driller. Swadlow & Sons Salem, Ore.

11. Infiltration Trench: Covered or open _____

Dimensions: Length _____ ft. Minimum depth _____ ft. Maximum depth _____ ft.

Bottom width _____ ft. Discharge _____ g.p.m. Date of test _____

12. Tunnel: Type of lining _____

Dimensions: _____
(Length, course, and cross sectional size)

Position of water bearing stratum with reference to portal of tunnel _____

Log of tunnel: (Preceding table for log of well may be used, if desired. Give footage from portal and character of materials, as pertinent.)

13. Pumping Equipment:

(a) Pump Fairbanks Morse turbine Capacity 300 g.p.m.
(Make, type and size)


(b) Motor Electric 25 hr.
(Type and horsepower)

14. Location of area irrigated or to be irrigated, or place of use if for purposes other than irrigation.

Township North or South	Range E. or W. of Willamette Meridian	Section	Forty-acre Tract	Number Acres To Be Irrigated	Date of Reclamation
65	2W	1	NE 1/4 of NE 1/4	18.5	1949
65	2W	1	SE 1/4 of NE 1/4	16.3	1949
				<u>34.8 Ac</u>	

15. If the ground water supply is supplemental to an existing water supply, identification of any application for a permit, permit, certificate or adjudicated right to appropriate water made or held by the registrant.

Township 6S Range 2W W.M.
North

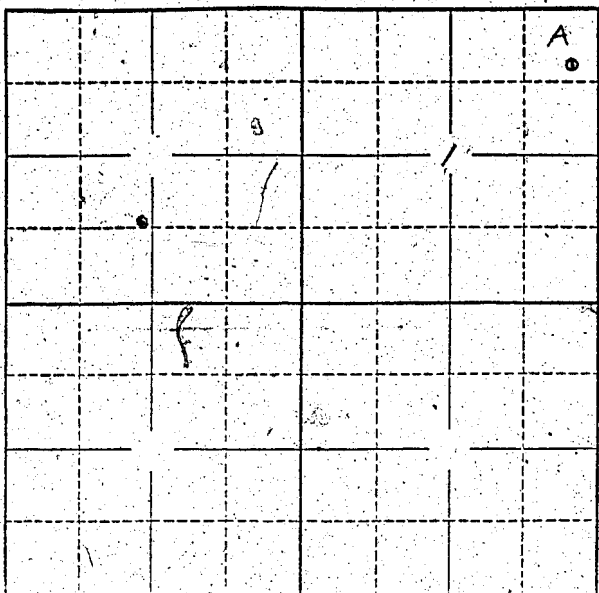

Locate well and acreage of irrigated land on plat.
Scale: 2" = 1 Mile

STATE OF OREGON

County of Marion } ss:

I, Clarence D. Herr, being first duly sworn, do hereby certify that I have read the foregoing Registration Statement and that all of the items therein contained are true to the best of my knowledge and belief.

Clarence D. Herr
(Signature of Registrant)

Subscribed and sworn to before me this 30 day of July, 1958

My commission expires April 26, 1960
William J. Lane
(Notary Public)

(SEAL)

CERTIFICATE OF REGISTRATION

STATE OF OREGON

County of Marion } ss.

This is to certify that the foregoing Registration Statement was received in the office of the State Engineer on the 30th day of July, 1958, at 11:10 o'clock A. M. and has been duly recorded in said office in Book No. 12 of Registration Statements on page GR- 2924

~~by _____ and the state engineer by _____~~

Witness my hand this 25th day of May, 1959

Lucrecia A. Stanley
(State Engineer)

By _____
(Deputy)

\$15.75

GR-2924