

Registration Statement

OF CLAIMANT OF RIGHT TO APPROPRIATE GROUND WATER

TO THE STATE ENGINEER OF OREGON:
John H Seavey

I, John H Seavey
of 2089 POTTER EUGENE County of LANE
State of OREGON, do hereby make application for a certificate of registration as evidence of a right to appropriate ground water.

1. Source from which water is withdrawn is Pump Well
(Flowing well, pump well, infiltration trench, or tunnel)

2. Location is: 3 miles North Goshen
(Approximate distance and direction from nearest city or town)

and is more particularly described as follows: BEGINNING AT POINT 2846.71' N AND 2655.30' E
BEING CENTER OF PRIVATE ROAD, running thence S 92° 33' W 155' thence S 15 feet.
3.5 Ch. North & 2.5 Ch. West from Ely corner
(Give distance and bearing to corner of section or other legal subdivision)

(a) being within SE 1/4 of Sec. 12, Twp. 18 S Rge. 3W
(Smallest legal subdivision) (N. or S.) (E. or W.)

or (b) within limits of recorded platted property, town or city: (3 1/2 Ch. N and 2 1/2 Ch. W from the 1/4 Cor. common to Sections 7 of 18S.2W and 12 of 18S.3W)

in Lot _____, Block _____ of _____
(Name of plat or addition)

County of Lane
(If within city or town, give name)

3. Construction Work was begun on Mar 1945; was completed on _____
(Date) (Date)

and the ground water claimed was first used for the purposes set out below on July 1945
(Date)

since which time the water has been used Intermittently
(Continuously or intermittently)

from MAY to SEPT
(Date) (Date)

4. Quantity of water claimed and used is 200 gallons per minute; 25 acre feet per year.

5. Purpose or Purposes for which water is used Irrigation
(Domestic, irrigation, municipal, manufacturing, industrial, etc.)

6. Description of Well: Depth 14 feet. Type Dug 30' wide, 400' long
(Dug or drilled)

diameter _____ inches. Elevation of ground at well site 460 feet, mean sea level.
(As near as known)

Depth to water table 10 feet.

7. Capacity of Well: _____ g.p.m. with _____ feet drawdown.

_____ g.p.m. with _____ feet drawdown.

Date of test Not tested

If Flowing Well: Measured discharge _____ g.p.m. on _____
(Date)

Shut-in pressure at ground surface _____ lbs. per sq. in. on _____
(Date)

Water is controlled by _____
(Cap, valve, etc.)

8. Casing: (Give diameter, commercial specifications and depth below ground surface of each casing size.)

DRY Summer Slough Hole

inch diameter from to feet
inch diameter from to feet
inch diameter from to feet
inch diameter from to feet

Describe and show depth of shoe, plug, adapter, liner or other details:

.....
.....

9. Perforated Casings or Screens:

..... from to
(Number per foot and size of perforations, or describe screen)
..... from to
..... from to
..... from to

10. Log of Well: (Describe each stratum or formation, clearly, indicate if water bearing, and give thickness and depth as indicated.)

MATERIAL	Thickness (Feet)	Depth to Bottom (Feet)
Soil	9	9
sand	1	10
few large rocks		

If log of well is not available, give name and address of driller.

11. Infiltration Trench: Covered or open

Dimensions: Length ft. Minimum depth ft. Maximum depth ft.

Bottom width ft. Discharge g.p.m. Date of test

12. Tunnel: Type of lining

Dimensions: (Length, course, and cross sectional size)

Position of water bearing stratum with reference to portal of tunnel

Log of tunnel: (Preceding table for log of well may be used, if desired. Give footage from portal and character of materials, as pertinent.)

13. Pumping Equipment:

(a) Pump *Centrifugal - Pacific Pumping Co.* Capacity *280* g.p.m.
(Make, type and size)

(b) Motor *Electric 5 HP*
(Type and horsepower)


14. Location of area irrigated or to be irrigated, or place of use if for purposes other than irrigation.

Township North or South	Range E. or W. of Willamette Meridian	Section	Forty-acre Tract	Number Acres To Be Irrigated	Date of Reclamation
18	SR2N	7	NW 1/4 of SW 1/4	5A	July 1945
18	SR2N	7	SW 1/4 of NW 1/4	20A	
18	SR2N	7	NW 1/4 of NW 1/4	5A	
				<u>30</u>	

15. If the ground water supply is supplemental to an existing water supply, identification of any application for a permit, permit, certificate or adjudicated right to appropriate water made or held by the registrant.

Township 185 Range 3W W.M.

North

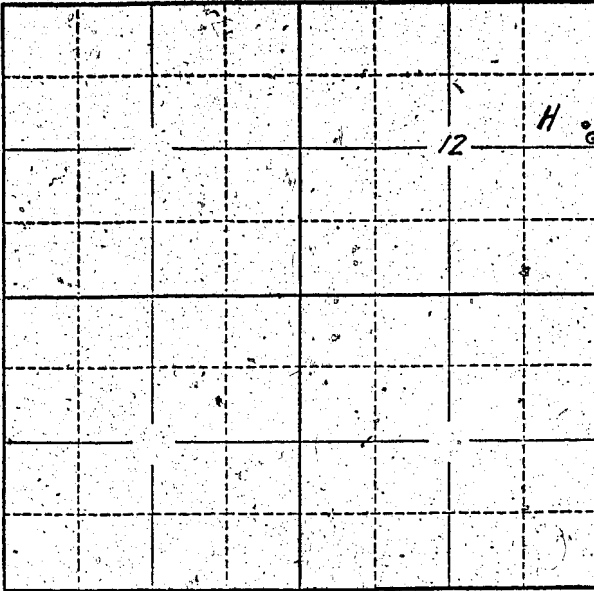

Locate well and acreage of irrigated land on plat.

Scale: 2" = 1 Mile

STATE OF OREGON

County of Lane

ss.

I, JOHN H. SEAVEY, being first duly sworn, do hereby certify that I have read the foregoing Registration Statement and that all of the items therein contained are true to the best of my knowledge and belief.

John H. Seavey
(Signature of Registrant)

Subscribed and sworn to before me this 14th day of March, 1958

My commission expires March 19, 1958

Kenneth Kierig
(Notary Public)

(SEAL)

CERTIFICATE OF REGISTRATION

STATE OF OREGON

County of Marion

ss.

This is to certify that the foregoing Registration Statement was received in the office of the State Engineer on the 30th day of July, 1958, at 2:00 o'clock P. M. and has been duly recorded in said office in Book No. 12 of Registration Statements on page GR-2929.

Witness my hand this 25th day of May, 1959

Laura A. Stanley
(State Engineer)

By _____ (Deputy)

#15.00

GR - 2929