

RECEIVED
JUL 10 1946
STATE ENGINEER

Registration No. GR- 3127

Certificate No. GR- 2934

Registration Statement

OF CLAIMANT OF RIGHT TO APPROPRIATE GROUND WATER

TO THE STATE ENGINEER OF OREGON:

I, McLaughlin, Robert S. (Vera E. Coleman) trustee
of P.O. Box 250, Corvallis, Oregon County of Benton
(Mailing address)

State of _____, do hereby make application for a certificate of registration as evidence of a right to appropriate ground water.

1. Source from which water is withdrawn is Pump Well
(Flowing well, pump well, infiltration trench, or tunnel)
2. Location is: 5 1/2 mi. SE. of Independence, Ore
(Approximate distance and direction from nearest city or town)

and is more particularly described as follows:

(a) 5 12° E 1430 ft from the N.E. CORNER of JNO. THORP D.L.C.
(Give distance and bearing to center of section or other legal subdivision)
being within NE 1/4 SW of Sec. 11, Twp. 9 S, Rge. 4 W
(Smallest legal subdivision) (N. or S.) (E. or W.)

or (b) within limits of recorded platted property, town or city: ~~Independence~~
in Lot _____, Block _____ of _____
(Name of plat or addition)

County of _____
(If within city or town, give name)

3. Construction Work was begun on July 15, 1946; was completed on July 20, 1946.
(Date) (Date)

and the ground water claimed was first used for the purposes set out below on 1946
(Date)

since which time the water has been used Intermittently
(Continuously or intermittently)

from 1946 to 1957
(Date) (Date)

4. Quantity of water claimed and used is 1065 gallons per minute; _____ acre feet per year.

5. Purpose or Purposes for which water is used Ind. 1946-1957

(Domestic, irrigation, municipal, manufacturing, industrial, etc.)

6. Description of Well: Depth 47 feet. Type Drilled
(Dug or drilled)

diameter 19" inches. Elevation of ground at well site _____ feet, mean sea level.
(As near as known)

Depth to water table 15 feet. Spring

7. Capacity of Well: 1065 g.p.m. with 5 feet drawdown.
_____ g.p.m. with _____ feet drawdown.


Date of test During July

If Flowing Well: Measured discharge _____ g.p.m. on _____
(Date)

Shut-in pressure at ground surface _____ lbs. per sq. in. on _____
(Date)

Water is controlled by _____
(Cap, valve, etc.)

Township 9S Range 4W, W.M.
North

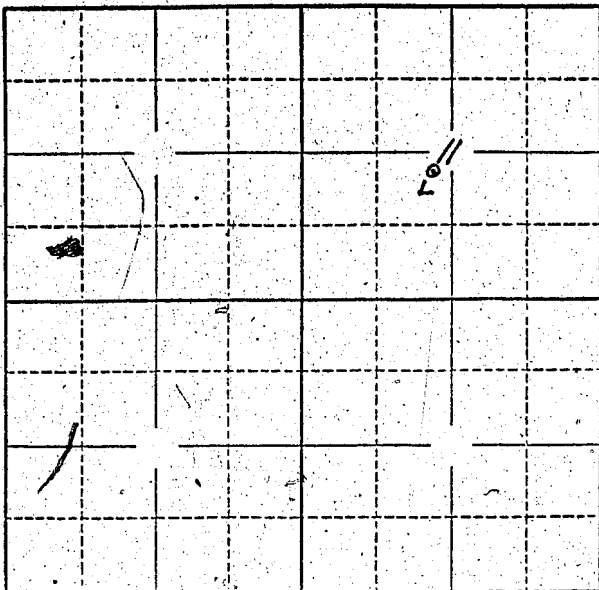

Locate well and acreage of irrigated land on plat.
Scale: 2" = 1 Mile

STATE OF ~~OREGON~~ CALIFORNIA } ss.
County of Butte

I, Robert L. McLaughlin, Trustee, being first duly sworn, do hereby certify that I have read the foregoing Registration Statement and that all of the items therein contained are true to the best of my knowledge and belief.

Robert L. McLaughlin
(Signature of Registrant)

Subscribed and sworn to before me this 28 day of July, 1958

My commission expires March 15 - 1962

[Signature]
(Notary Public)

(SEAL)

CERTIFICATE OF REGISTRATION

STATE OF OREGON } ss.
County of Marion

This is to certify that the foregoing Registration Statement was received in the office of the State Engineer on the 30 day of July, 1958, at 5:00 o'clock A. M. and has been duly recorded in said office in Book No. 12 of Registration Statements on page GR-2934

Witness my hand this 25th day of May, 1959.

Lewis A. Stanley
(State Engineer)

\$16.65

By _____ (Deputy)