

Registration No. GR- 3128

Certificate No. GR 3976

Registration Statement

OF CLAIMANT OF RIGHT TO APPROPRIATE GROUND WATER

TO THE STATE ENGINEER OF OREGON:

I, Lester E. Tetreau

of 3111 S. E. Concord Road Milwaukie 22 County of Clatsamas
(Mailing address)

State of Oregon, do hereby make application for a certificate of registration as evidence of a right to appropriate ground water.

1. Source from which water is withdrawn is Pump Well
(Flowing well, pump well, infiltration trench, or tunnel)

2. Location is: 3 Miles South of Milwaukie
(Approximate distance and direction from nearest city or town)

and is more particularly described as follows:

(a) 1400 feet north & 500 feet west from S 1/4 corner Section 12
(Give distance and bearing to corner of section or other legal subdivision)

being within Concord NE 1/4 SW 1/4 of Sec. 12 Twp. 25 Rge. 1 E
(Smallest legal subdivision) (E. or W.)

or East (b) within limits of recorded platted property, town or city:

half of Tract No 7 on Concord Road
in Lot _____, Block _____ of _____
(Name of plat or addition)

County of Clatsamas
(If within city or town, give name)

3. Construction Work was begun on unk.; was completed on July 28, 1941
(Date) (Date)

and the ground water claimed was first used for the purposes set out below on August 1941
(Date)

since which time the water has been used intermittently
(Continuously or intermittently)

from 1941 to 1957
(Date) (Date)

4. Quantity of water claimed and used is 300 gallons gallons per minute; _____ acre feet per year.

5. Purpose or Purposes for which water is used Irrigation

(Domestic, irrigation, municipal, manufacturing, industrial, etc.)

6. Description of Well: Depth 265 feet. Type Drilled
(Dug or drilled)

diameter 8 inches. Elevation of ground at well site _____ feet, mean sea level.
(As near as known)

Depth to water table 8.3 feet.

7. Capacity of Well: 200 g.p.m. with 9 feet drawdown.

350 g.p.m. with 18 feet drawdown.

Date of test July 28, 1941

If Flowing Well: Measured discharge _____ g.p.m. on _____
(Date)

Shut-in pressure at ground surface _____ lbs. per sq. in. on _____
(Date)

Water is controlled by _____
(Cap, valve, etc.)

If log of well is not available, give name and address of driller. _____

11. Infiltration Trench: Covered or open _____

Dimensions: Length _____ ft. Minimum depth _____ ft. Maximum depth _____ ft.
 Bottom width _____ ft. Discharge _____ g.p.m. Date of test _____

12. Tunnel: Type of lining _____

Dimensions: _____ (Length, depth, and cross sectional size)
 Position of water bearing stratum with reference to portal of tunnel _____

Log of tunnel: (Preceding table for log of well may be used; if desired. Give footage from portal and character of materials, as pertinent.)

13. Pumping Equipment:


(a) Pump Pomona Capacity 300 g.p.m.
(Make, type and size)
 (b) Motor Electric 15 horse power
(Type and horsepower)

14. Location of area irrigated or to be irrigated, or place of use if for purposes other than irrigation.

Township North or South	Range E. or W. of Willamette Meridian	Section	Forty-acre Tract	Number Acres To Be Irrigated	Date of Reclamation
25	1E	12	NE 1/4 of SW 1/4	2 1/2	1941
"	"	"	SE 1/4 of SW 1/4	2.0	"
				<u>4.5</u> Ac	

15. If the ground water supply is supplemental to an existing water supply, identification of any application for a permit, permit, certificate or adjudicated right to appropriate water made or held by the registrant.

Township 25 Range 1 E, W.M.
North

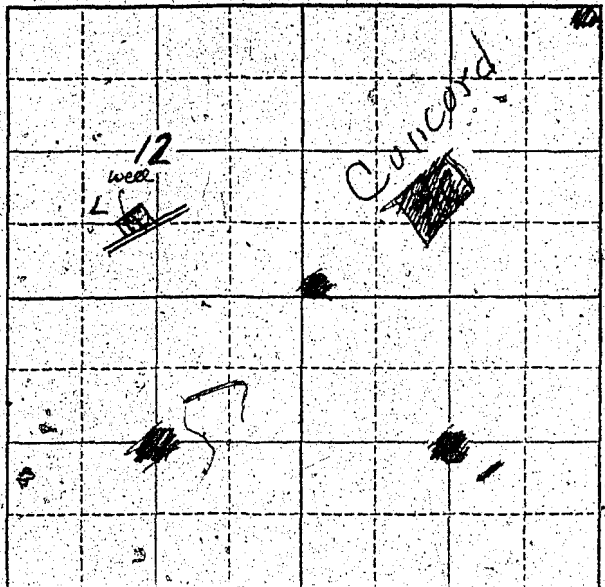

Locate well and acreage of irrigated land on plat.
Scale: 2" = 1 Mile

STATE OF OREGON }
County of CLACKAMAS } ss.

I, LESTER E. TATREAU, being first duly sworn, do hereby certify that I have read the foregoing Registration Statement and that all of the items therein contained are true to the best of my knowledge and belief.

Lester E. Tatreau
(Signature of Registrant)

Subscribed and sworn to before me this 26th day of JULY, 1958.

My commission expires Sept. 25, 1959.

M.H. Reeves
(Notary Public)

(SEAL)

CERTIFICATE OF REGISTRATION

STATE OF OREGON }
County of Marion } ss.

This is to certify that the foregoing Registration Statement was received in the office of the State Engineer on the 30th day of July, 1958, at 2:00 o'clock A.M. and has been duly recorded in said office in Book No. 16 of Registration Statements on page GR-3976

Witness my hand this 15th day of February, 1960

Lawrence A. Stanley
(State Engineer)

\$15.00

By _____
(Deputy)