

RECEIVED  
STATE ENGINEER  
SALEM, OREGON

Registration No. GR. - 3/29

Certificate No. GR. - 2935

# Registration Statement

## OF CLAIMANT OF RIGHT TO APPROPRIATE GROUND WATER

TO THE STATE ENGINEER OF OREGON:

I, Ro'scoe E and Louise A Clark

of Route 1 Box 456 Salem County of Polk

State of Oregon, do hereby make application for a certificate of registration as evidence of a right to appropriate ground water.

1. Source from which water is withdrawn is pump well  
(Flowing well, pump well, infiltration trench, or tunnel)

2. Location is: 8 miles from West Salem Oregon  
(Approximate distance and direction from nearest city or town)

and is more particularly described as follows: 5048' E & 1227' S from

(a) 6600' E of the Northwest corner of the C.C. Walker DL  
(Give distance and bearing to corner of section or other legal subdivision)

being within NE 1/4 SW 1/4 of Sec. 19, Twp. 6 S, Rge. 3 W  
(Smallest legal subdivision) (N. or S.) (E. or W.)

or (b) within limits of recorded platted property, town or city: \_\_\_\_\_

in Lot \_\_\_\_\_, Block \_\_\_\_\_ of \_\_\_\_\_  
(Name of plat or addition)

Polk County of Oregon  
(If within city or town, give name)

3. Construction Work was begun on February 1953 was completed on June 1953  
(Date) (Date)

and the ground water claimed was first used for the purposes set out below on June 1953  
(Date)

since which time the water has been used continuously (irrigation seasons)  
(Continuously or intermittently)

from June 1953 to date  
(Date) (Date)

4. Quantity of water claimed and used is 250 gallons per minute; acre feet unknown acre feet per year.

5. Purpose or Purposes for which water is used irrigate stock pasture

(Domestic, irrigation, municipal, manufacturing, industrial, etc.)

6. Description of Well: Depth 70 feet. Type drilled  
(Dug or drilled)

diameter 24 inches. Elevation of ground at well site 90 feet, mean sea level.  
(As near as known)

Depth to water table 20 feet.

7. Capacity of Well: 250 g.p.m. with 20 feet drawdown.

\_\_\_\_\_ g.p.m. with \_\_\_\_\_ feet drawdown.

Date of test February 1953

If Flowing Well: Measured discharge \_\_\_\_\_ g.p.m. on \_\_\_\_\_  
(Date)


Shut-in pressure at ground surface \_\_\_\_\_ lbs. per sq. in. on \_\_\_\_\_  
(Date)

Water is controlled by \_\_\_\_\_  
(Cap, valve, etc.)





Township 65 Range 3W W.M.  
North

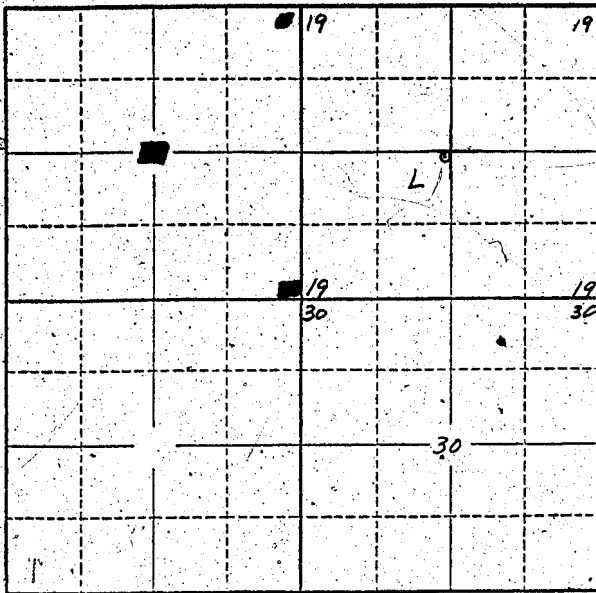

Locate well and acreage of irrigated land on plat.  
Scale: 2" = 1 Mile

STATE OF OREGON

County of Marion } ss.

I, \_\_\_\_\_, being first duly sworn, do hereby certify that I have read the foregoing Registration Statement and that all of the items therein contained are true to the best of my knowledge and belief.

Roscoe E. Clark  
Louise A. Clark  
(Signature of Registrant)

Subscribed and sworn to before me this 28 day of July, 1958

My commission expires Nov. 23 1958 Blanche Nickel  
(Notary Public)

(SEAL)

**CERTIFICATE OF REGISTRATION**

STATE OF OREGON

County of Marion } ss.

This is to certify that the foregoing Registration Statement was received in the office of the State Engineer on the 30th day of July, 1958, at 8:00 o'clock A. M. and has been duly recorded in said office in Book No. 12 of Registration Statements on page GR-2935

Witness my hand this 25th day of May, 1959

Lewis A. Stanley  
(State Engineer)

By \_\_\_\_\_ (Deputy)

GR-2935

\$15.00