

RECEIVED
NOV 1956
STATE ENGINEER

REGISTRATION NO. GR-313

CERTIFICATE NO. GR-294

Registration Statement

OF CLAIMANT OF RIGHT TO APPROPRIATE GROUND WATER

(Under Chapter 708, Oregon Laws 1955.)

TO THE STATE ENGINEER OF OREGON:

I, J. C. Neil
of 908 Church St, Dallas County of Polk

State of Oregon do hereby make application for a certificate of registration as evidence of a right to appropriate ground water.

1. Source from which water is withdrawn is Pump well
(Flowing well, pump well, infiltration trench, or tunnel)

2. Location is: 1/2 mile West + 1/4 mile South from Independence
(Approximate distance and direction from nearest city or town) Oregon

and is more particularly described as follows:

(a) 3520' N 43° W SW corner
(Give distance and bearing to corner of section or other legal subdivision)
being within NE 1/4 of Sec 7 of Sec. 29, Twp. 8 S, Rge. 4 W
(Smallest legal subdivision) (N. or S.) (E. of W.)

or (b) within limits of recorded platted property, town or city:

in Lot _____, Block _____ of _____
(Name of plat or addition)

County of Polk
(If within city or town, give name)

3. Construction Work was begun on March 1948; was completed on March 1948
(Date) (Date)

and the ground water claimed was first used for the purposes set out below on Aug. 1948
(Date)

since which time the water has been used continuously - May - Oct. every year
(Continuously or intermittently)

from 1948 to present
(Date) (Date)

4. Quantity of water claimed and used is 112 gallons per minute; 17 acre feet per year.

5. Purpose or Purposes for which water is used irrigation

(Domestic, irrigation, municipal, manufacturing, industrial, etc.)

6. Description of Well: Depth 68 feet. Type: Drilled
(Dug or drilled)

diameter 11 inches. Elevation of ground at well site 150 feet, mean sea level.
(As near as known)

Depth to water table 25 feet.

7. Capacity of Well: 112 g.p.m. with 5 feet drawdown.

_____ g.p.m. with _____ feet drawdown.

Date of test _____

If Flowing Well: Measured discharge N/A g.p.m. on _____
(Date)

Shut-in pressure at ground surface _____ lbs. per sq. in. on _____
(Date)

Water is controlled by _____
(Cap, valve, etc.)

8. Casing: (Give diameter, commercial specifications and depth below ground surface of each casing size.)

11 inch diameter from 0 to 68 feet
..... inch diameter from to feet
..... inch diameter from to feet
..... inch diameter from to feet

Describe and show depth of shoe, plug, adapter, liner or other details:

9. Perforated Casings or Screens:

20 1/2" x 10" perforations per foot from 47 ft to 68 ft
(Number per foot and size of perforations, or describe screen)
..... from to
..... from to
..... from to

10. Log of Well: (Describe each stratum or formation clearly, indicate if water bearing, and give thickness and depth as indicated.)

MATERIAL	Thickness (Feet)	Depth to Bottom (Feet)
Silty Clay loam	20 ft.	20 ft.
Blue Clay	30 ft.	50 ft.
Gravel	18 ft.	68 ft.

If log of well is not available, give name and address of driller.

11. Infiltration Trench: Covered open *N/A*
 Dimensions: Length ft. Minimum depth ft. Maximum depth ft.
 Bottom width ft. Discharge g.p.m. Date of test :

12. Tunnel: Type of lining *N/A*
 Dimensions:
(Length, course, and cross sectional size)
 Position of water bearing stratum with reference to portal of tunnel

Log of tunnel: (Preceding table for log of well may be used, if desired. Give footage from portal and character of materials, as pertinent.)

13. Pumping Equipment:
 (a) Pump *Jacuzzi, Jet, 4 inch* Capacity g.p.m.
(Make, type and size)
 (b) Motor *Electric 7 1/2 HP.*
(Type and horsepower)

14. Location of area irrigated or to be irrigated, or place of use if for purposes other than irrigation.


Township North or South	Range E. or W. of Willamette Meridian	Section	Forty-acre Tract	Number Acres To Be Irrigated	Date of Reclamation
8 S	4 W	29	NW 1/4 of Sec 1	12 ⁸ / ₁₀	March 1948
8 S	4 W	29	SE 1/4 of NW 1/4	4 ⁰ / ₁₀	1948

15. If the ground water supply is supplemental to an existing water supply, identification of any application for a permit, permit, certificate or adjudicated right to appropriate water made or held by the registrant.

N/A

Township 8.5 Range 4.0 W.M.

Section 29

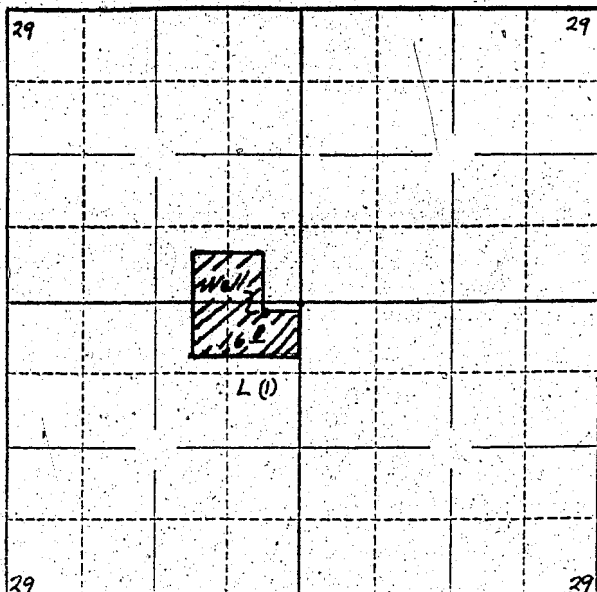

Locate well and acreage of irrigated land on plat.

Scale: 2" = 1 Mile 4" = 1 Mile

STATE OF OREGON



[Handwritten Signature]
(Signature of Registrant)

Subscribed and sworn to before me this 12th day of December, 1956.

My commission expires My Commission Expires Jan. 16, 1958

[Handwritten Signature]
(Notary Public)

(SEAL)

CERTIFICATE OF REGISTRATION

STATE OF OREGON

County of Marion } ss.

This is to certify that the foregoing Registration Statement was received in the office of the State Engineer on the 12th day of December, 1956, at 9 o'clock A. M. and has been duly recorded in said office in Book No. 2 of Registration Statements on page GR-294-C.

~~Construction shall be completed by X-X-X-X-X-X-X-X-X-X and the water completely applied to beneficial use by X-X-X-X-X-X-X-X-X-X.~~

Witness my hand this 15th day of January, 1957.

Lewis A. Stanley
(State Engineer)

By (Deputy)

GR-294C