

# Registration Statement

## OF CLAIMANT OF RIGHT TO APPROPRIATE GROUND WATER

(Under Chapter 708, Oregon Laws 1955.)

TO THE STATE ENGINEER OF OREGON:

I, REUBEN REIST + HILDA REIST  
of P.O. Box 497 SALEM County of YAMHILL

State of OREGON do hereby make application for a certificate of registration as evidence of a right to appropriate ground water.

1. Source from which water is withdrawn is PUMP WELL  
(Flowing well, pump well, infiltration trench, or tunnel)

2. Location is: 1 MI. SOUTH HOPEWELL STORE  
(Approximate distance and direction from nearest city or town)

and is more particularly described as follows:

(a) 350 feet west & 1370 feet south from NE corner Section 6  
(Give distance and bearing to corner of section or other legal subdivision)

being within SE 1/4 of NE 1/4 of Sec. 6, Twp. 6 S, Rge. 3 W  
(Smallest legal subdivision) (N. or S.) (E. or W.)

or (b) within limits of recorded platted property, town or city:

in Lot \_\_\_\_\_, Block \_\_\_\_\_ of \_\_\_\_\_  
(Name of plat or addition)

County of \_\_\_\_\_  
(If within city or town, give name)

3. Construction Work was begun on July 28-1953<sup>3</sup>; was completed on Aug 5-1953  
(Date) (Date)

and the ground water claimed was first used for the purposes set out below on June 1-1954  
(Date)

since which time the water has been used domestic continuously, irrigation in season  
(Continuously or intermittently)

from June 1-1954 to Oct 1957  
(Date) (Date)

4. Quantity of water claimed and used is 40 gallons per minute; \_\_\_\_\_ acre feet per year.

5. Purpose or Purposes for which water is used domestic and irrigation

(Domestic, irrigation, municipal, manufacturing, industrial, etc.)

6. Description of Well: Depth 120 feet. Type drilled  
(Dug or drilled)

diameter 6 inches. Elevation of ground at well site \_\_\_\_\_ feet, mean sea level.  
(As near as known)

Depth to water table 40 feet.

7. Capacity of Well: 30 g.p.m. with 30 feet drawdown.

40 g.p.m. with 60 feet drawdown.

Date of test Aug 6 1953

If Flowing Well: Measured discharge \_\_\_\_\_ g.p.m. on \_\_\_\_\_  
(Date)

Shut-in pressure at ground surface \_\_\_\_\_ lbs. per sq. in. on \_\_\_\_\_  
(Date)

Water is controlled by \_\_\_\_\_  
(Cap, valve, etc.)

8. Casing: (Give diameter, commercial specifications and depth below ground surface of each casing size.)

6 inch diameter ..... from surface to 65 feet  
 ..... inch diameter ..... from ..... to ..... feet  
 ..... inch diameter ..... from ..... to ..... feet  
 ..... inch diameter ..... from ..... to ..... feet

Describe and show depth of shoe, plug, adapter, liner or other details: .....

*Lower part of well has no casing*

9. Perforated Casings or Screens:

(Number per foot and size of perforations, or describe screen) ..... from ..... to .....  
 ..... from ..... to .....  
 ..... from ..... to .....  
 ..... from ..... to .....

10. Log of Well: (Describe each stratum or formation clearly, indicate if water bearing, and give thickness and depth as indicated.)

MATERIAL	Thickness (Feet)	Depth to Bottom (Feet)
Surface	0-18	
surface water	18-23	
red clay and boulders	23-64	
rock with water	64-120	120

If log of well is not available, give name and address of driller. *T. Miller*

11. Infiltration Trench: Covered or open .....

Dimensions: Length ..... ft. Minimum depth ..... ft. Maximum depth ..... ft.  
Bottom width ..... ft. Discharge ..... g.p.m. Date of test .....

12. Tunnel: Type of lining .....

Dimensions: .....  
(Length, course, and cross sectional size)  
Position of water bearing stratum with reference to portal of tunnel .....

Log of tunnel: (Preceding table for log of well may be used, if desired. Give footage from portal and character of materials, as pertinent.)

13. Pumping Equipment:

(a) Pump *Submersible - Fairbanks-Morse* Capacity *40* g.p.m.  
(Make, type and size)  
(b) Motor *2 H.P. Electric Motor*  
(Type and horsepower)


14. Location of area irrigated or to be irrigated, or place of use if for purposes other than irrigation.

Township North or South	Range - E. or W. of Willamette Meridian	Section	Forty-acre Tract	Number Acres To Be Irrigated	Date of Reclamation
<i>T6S</i>	<i>R3W</i>	<i>6</i>	<i>NE 1/4 of NE 1/4</i>	<i>6.5 Ac</i>	<i>1954</i>
<i>"</i>	<i>"</i>	<i>6</i>	<i>SE 1/4 of NE 1/4</i>	<i>5.5 Ac</i>	<i>"</i>
				<i>12.0 Total</i>	<i>"</i>

15. If the ground water supply is supplemental to an existing water supply, identification of any application for a permit, permit, certificate or adjudicated right to appropriate water made or held by the registrant.

Township 6S Range 3W, W.M.

North

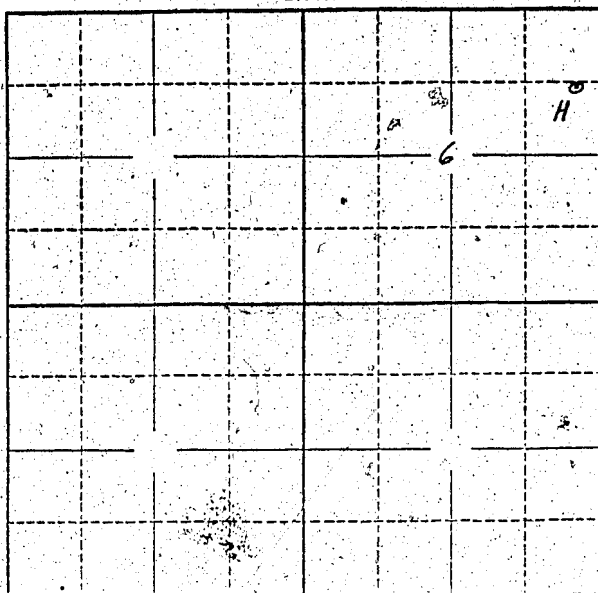

Locate well and acreage of irrigated land on plat.

Scale: 2" = 1 Mile

STATE OF OREGON

County of Yamhill

SS.

we

WE, X Rauben Reist & Hilda Reist, being first duly sworn, do hereby certify that I have read the foregoing Registration Statement and that all of the items therein contained are true to the best of our ~~own~~ knowledge and belief.

X Rauben Reist  
Hilda Reist

(Signature of Registrant)

Subscribed and sworn to before me this 29 day of July, 1958.

My commission expires April 19, 1960

George Dan Oakes  
(Notary Public)

(SEAL)

**CERTIFICATE OF REGISTRATION**

STATE OF OREGON

County of Marion

SS.

This is to certify that the foregoing Registration Statement was received in the office of the State Engineer on the 30<sup>th</sup> day of July, 1958, at 8:00 o'clock A. M. and has been duly recorded in said office in Book No. 12 of Registration Statements on page GR-2936

~~Construction shall be completed by 1959 and the cost shall be paid tax~~  
~~therefor by 1959~~

Witness my hand this 25<sup>th</sup> day of May, 1959.

Lewis A. Stanley  
(State Engineer)

By \_\_\_\_\_ (Deputy)

**GR-2936**

# 15.00