

Registration Statement,

OF CLAIMANT OF RIGHT TO APPROPRIATE GROUND WATER

TO THE STATE ENGINEER OF OREGON:

I, NEIL B. WIGHT

of RT. 1, BOX 547 WARREN, OREGON County of COLUMBIA

State of OREGON, do hereby make application for a certificate of registration as evidence of a right to appropriate ground water.

1. Source from which water is withdrawn is pump well
(Flowing well, pump well, infiltration trench, or tunnel)

2. Location is: southwest of St. Helens four miles
(Approximate distance and direction from nearest city or town)

and is more particularly described as follows:

(a) North 1016.0' and East 1912.0' from the Southwest corner of NW 1/4
(Give distance and bearing to corner of section or other legal subdivision)

being within SE 1/4 of NW 1/4 of Sec. 24, Twp. 4 N, Rge. 2 W
(Smallest legal subdivision) (N. or S.) (E. or W.)

or (b) within limits of recorded platted property, town or city:

in Lot _____ Block _____ of _____
(Name of plat or addition)

County of _____
(If within city or town, give name)

3. Construction Work was begun on July 19, 1955; was completed on July 26, 1955
(Date) (Date)

and the ground water claimed was first used for the purposes set out below on July 17, 1958
(Date)

since which time the water has been used continuously
(Continuously or intermittently)

from July 17, 1958 to July 28, 1958
(Date) (Date)

4. Quantity of water claimed and used is thirty gallons per minute; 20 acre feet per year.

5. Purpose or Purposes for which water is used: domestic and irrigation

(Domestic, irrigation, municipal, manufacturing, industrial, etc.)

6. Description of Well: Depth 133 feet. Type drilled
(Dug or drilled)

diameter 8 inches. Elevation of ground at well site 180 feet, mean sea level.
(As near as known)

Depth to water table 69 TO 90 feet.

7. Capacity of Well: 25 g.p.m. with 122 feet drawdown.

37 g.p.m. with 128 feet drawdown.


Date of test 7/8/58

If Flowing Well: Measured discharge _____ g.p.m. on _____
(Date)

Shut-in pressure at ground surface _____ lbs. per sq. in. on _____
(Date)

Water is controlled by: _____
(Cap. valve, etc.)

Township 4N Range 2W, W.M.
North

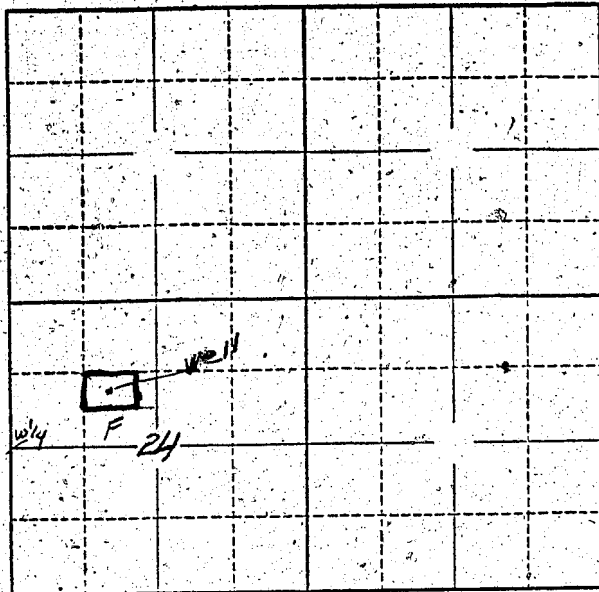

Locate well and acreage of irrigated land on plat.
Scale: 2" = 1 Mile

STATE OF OREGON }
County of Columbia } ss.

I, Neil B. Wight, being first duly sworn, do hereby certify that I have read the foregoing Registration Statement and that all of the items therein contained are true to the best of my knowledge and belief.

Neil B. Wight
(Signature of Registrant)

Subscribed and sworn to before me this 29th day of July, 1958.

My commission expires 11-22-58

Neil K. Johnson
(Notary Public)

(SEAL)

CERTIFICATE OF REGISTRATION

STATE OF OREGON }
County of Marion } ss.

This is to certify that the foregoing Registration Statement was received in the office of the State Engineer on the 30th day of July, 1958, at 8:00 o'clock A. M. and has been duly recorded in said office in Book No. 12 of Registration Statements on page GR 2942

Witness my hand this 25th day of May, 1959

Lewis A. Stanley
(State Engineer)

By _____ (Deputy)

\$15.00

GR - 2942