

RECEIVED
MAY 2 1951
STATE ENGINEER

REGISTRATION NO. GR-314
CERTIFICATE NO. GR-295

Registration Statement

OF CLAIMANT OF RIGHT TO APPROPRIATE GROUND WATER

(Under Chapter 708, Oregon Laws 1955.)

TO THE STATE ENGINEER OF OREGON:

I, Andy and Annabelle Hetzerdorf

of Rt. 1, Box 35, Lebanon County of Linn

State of Oregon, do hereby make application for a certificate of registration as evidence of a right to appropriate ground water.

1. Source from which water is withdrawn is pump well
(Flowing well, pump well, infiltration trench, or tunnel)

2. Location is: 2 miles SE of Lebanon, Oregon
(Approximate distance and direction from nearest city or town)

and is more particularly described as follows:

(a) S. 16° 15' E. 1300.1 feet from the NW corner of S. 24, T. 12 S., R. 2 W.W.M.
(Give distance and bearing to corner of section or other legal subdivision)

being within NW 1/4 of NW 1/4 of Sec. 24, Twp. 12 S., Rge. 2 W.
(Smallest legal subdivision) (N. or S.) (E. or W.)

or (b) within limits of recorded platted property, town or city:

in Lot _____, Block _____ of _____
(Name of plat or addition)

County of Linn
(If within city or town, give name)

3. Construction Work was begun on May 20, 1951; was completed on May 30, 1951
(Date) (Date)

and the ground water claimed was first used for the purposes set out below on June 2, 1951
(Date)

since which time the water has been used continuously
(Continuously or Intermittently)

from June 2, 1951 to present time
(Date) (Date)

4. Quantity of water claimed and used is 150 gallons per minute; 27 acre feet per year.

5. Purpose or Purposes for which water is used Irrigation

(Domestic, irrigation, municipal, manufacturing, industrial, etc.)

6. Description of Well: Depth 19 feet. Type drilled
(Dug or drilled)

diameter 10 inches. Elevation of ground at well site 360 feet, mean sea level.
(As near as known)

Depth to water table 8 feet.

7. Capacity of Well: 150 g.p.m. with 4 feet drawdown.

_____ g.p.m. with _____ feet drawdown.

Date of test Not tested

If Flowing Well: Measured discharge _____ g.p.m. on _____
(Date)

Shut-in pressure at ground surface _____ lbs. per sq. in. on _____
(Date)

Water is controlled by _____
(Cap, valve, etc.)

8. Casing: (Give diameter, commercial specifications and depth below ground surface of each casing size.)

10 inch diameter steel casing from 0 to 19 feet
 inch diameter from to feet
 inch diameter from to feet
 inch diameter from to feet

Describe and show depth of shoe, plug, adapter, liner or other details:

9. Perforated Casings or Screens:

Dynamited from to
(Number per foot and size of perforations, or describe screen)
 from to
 from to
 from to

10. Log of Well: (Describe each stratum or formation clearly, indicate if water bearing, and give thickness and depth as indicated.)

MATERIAL	Thickness (Feet)	Depth to Bottom (Feet)
Not available.		

If log of well is not available, give name and address of driller.

11. Infiltration Trench: Covered or open

Dimensions: Length ft. Minimum depth ft. Maximum depth ft.

Bottom width ft. Discharge g.p.m. Date of test

12. Tunnel: Type of lining

Dimensions:
(Length, course, and cross sectional size)

Position of water bearing stratum with reference to portal of tunnel

Log of tunnel: (Preceding table for log of well may be used, if desired. Give footage from portal and character of materials, as pertinent.)

13. Pumping Equipment:

(a) Pump 2 inch Gould Centrifugal Capacity 200 g.p.m.
(Make, type and size)

(b) Motor 5 H. P. Electric
(Type and horsepower)

14. Location of area irrigated or to be irrigated, or place of use if for purposes other than irrigation.


Township North or South	Range E. or W. of Willamette Meridian	Section	Forty-acre Tract	Number Acres To Be Irrigated	Date of Reclamation
12 S	2 W	24	NW $\frac{1}{4}$ of NW $\frac{1}{4}$	8.6	June 2, 1951
12 S	2 W	24	SW $\frac{1}{4}$ of NW $\frac{1}{4}$	2.2	June 2, 1951
				10.8	

Beginning at a 1 $\frac{1}{2}$ " iron pipe on the North line of and S. 89°32' E. 302.30 feet from the Northwest corner of the North projection of the Richard Cheadle D.L.C. No. 26 in T. 12 S., R. 2 W. of the Will. Mer. in Lin. Count., Oregon; and running thence N. 0°03' E. 902.5 feet, more or less, to the Southerly bank of the South Santiam River; thence Southeasterly along the Southerly bank of said river to a point which bears N. 0°23' E. of a 3/4" iron pipe on the North line of and S. 89°32' E. 1158.4 feet from the Northwest corner of the North projection of said Richard Cheadle D.L.C; thence S. 0°23' W. 1390 feet, more or less, to the North bank of the Lebanon-Santiam Canal; thence westerly along the North bank of said canal to a point S. 0°03' E. of the place of beginning; thence N. 0°03' E. 642 feet, more or less, to the place of beginning, excepting therefrom that part lying within the right of way of the Lebanon-Santiam Canal, leaving 11.4 acres, more or less; subject to the rights of the public in the use of the county road.

15. If the ground water supply is supplemental to an existing water supply, identification of any application for a permit, permit, certificate or adjudicated right to appropriate water made or held by the registrant.

Township 12 S Range 2 W W.M.

North

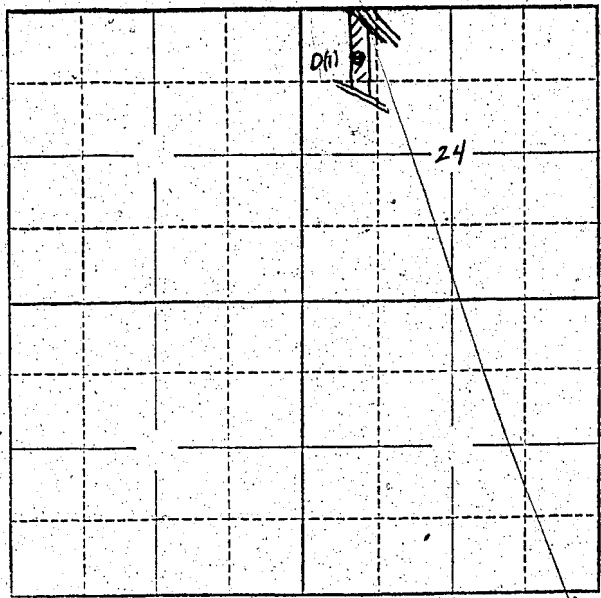

Locate well and acreage of irrigated land on plat.

Scale: 2" = 1 Mile

STATE OF OREGON

County of Linn } ss.

I, Andy and Annabella Hatzendorf, being first duly sworn, do hereby certify that I have read the foregoing Registration Statement and that all of the items therein contained are true to the best of my knowledge and belief.

Annabella Hatzendorf
Andy Hatzendorf
(Signature of Registrant)

Subscribed and sworn to before me this 1st day of December, 1956

My commission expires July 22 - 1959

(Notary Public)

(SEAL)

CERTIFICATE OF REGISTRATION

STATE OF OREGON

County of Marion } ss.

This is to certify that the foregoing Registration Statement was received in the office of the State Engineer on the 7th day of December, 1956, at 8 o'clock A.M. and has been duly recorded in said office in Book No. 2 of Registration Statements on page GR-295-C


Witness my hand this 15th day of January, 1957

Lewis A. Stanley
(State Engineer)

By _____ (Deputy)

GR-295 C