

Registration Statement

OF CLAIMANT OF RIGHT TO APPROPRIATE GROUND WATER

TO THE STATE ENGINEER OF OREGON:

I, Floyd L. Bailey
of Rte. 2 Box 96 County of Lane
(Mailing address)

State of Oregon do hereby make application for a certificate of registration as evidence of a right to appropriate ground water.

1. Source from which water is withdrawn is Open Well
(Pumping well, pump well, filtration trench, or tunnel)

2. Location is: 1 1/2 miles West Springfield
(Approximate distance and direction from nearest city or town)

and is more particularly described as follows:

(a) 950 ft. North and 200 ft. West of S.E. corner Sec. 28
(Give distance and bearing to corner or other legal subdivision)
being within S.E. 1/4 of S.E. 1/4 of Sec. 28, Twp. 17S, Rge. 3 W. 1/2 M.
(Smallest legal subdivision) (N. or S.) (E. or W.)

or (b) within limits of recorded platted property, town or city:

in Lot _____; Block _____ of _____
(Name of plat or addition)

County of _____
(If within city or town, give name)

3. Construction Work was begun on 1940; was completed on 1940
(Date) (Date)

and the ground water claimed was first used for the purposes set out below on 1941
(Date)

since which time the water has been used intermittently - Each year
(Continuously or intermittently)

from May to October
(Date) (Date)

4. Quantity of water claimed and used is 25 gallons per minute; 2 acre feet per year.

5. Purpose or Purposes for which water is used Irrigation
(Domestic, irrigation, municipal, manufacturing, industrial, etc.)

6. Description of Well: Depth 22 feet. Type Dug
(Dug or drilled)
diameter 48 inches. Elevation of ground at well site 925 feet, mean sea level.
(As near as known)

Depth to water table from 8 - 21 feet.

7. Capacity of Well: 30 g.p.m. with 2 feet drawdown.
_____ g.p.m. with _____ feet drawdown.


Date of test 1941

If Flowing Well: Measured discharge _____ g.p.m. on _____
(Date)

Shut-in pressure at ground surface _____ lbs. per sq. in. on _____
(Date)

Water is controlled by _____
(Cap, valve, etc.)

Township 17 S Range 3 W, W.M.
North

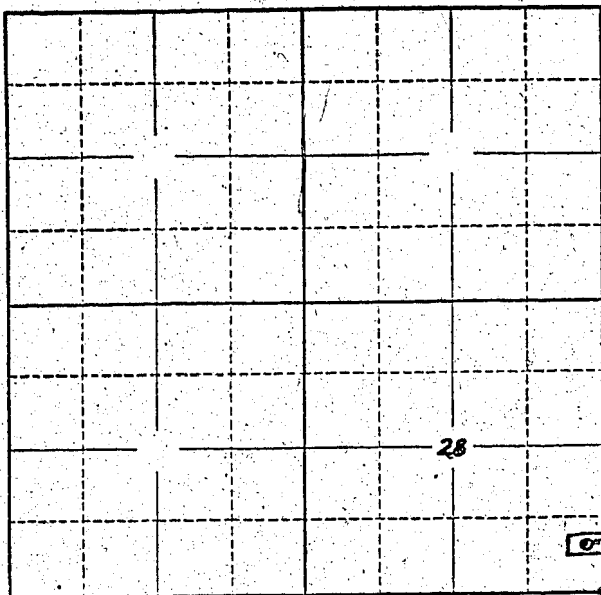

Locate well and acreage of irrigated land on plat.
Scale: 2" = 1 Mile

STATE OF OREGON

County of Lane } ss.

I, Floyd L Bailey, being first duly sworn, do hereby certify that I have read the foregoing Registration Statement and that all of the items therein contained are true to the best of my knowledge and belief.

x Floyd L Bailey
(Signature of Registrant)

Subscribed and sworn to before me this 28th day of July, 1958

My commission expires Sept. 9, 1960 Gordon C Brunter
(Notary Public)

(SEAL)

CERTIFICATE OF REGISTRATION

STATE OF OREGON

County of Marion } ss.

This is to certify that the foregoing Registration Statement was received in the office of the State Engineer on the 26th day of July, 1958, at 8:00 o'clock A. M. and has been duly recorded in said office in Book No. 12 of Registration Statements on page GR-2946

Witness my hand this 25th day of May, 1959

Lewis D. Stanley
(State Engineer)

By _____ (Deputy)

\$15.00