

Registration Statement

OF CLAIMANT OF RIGHT TO APPROPRIATE GROUND WATER

TO THE STATE ENGINEER OF OREGON:

I, George Neuman
of Rt 2 Box 80A Philomath County of Benton
(Mailing address)

State of Oregon, do hereby make application for a certificate of registration as evidence of a right to appropriate ground water.

- 1. Source from which water is withdrawn is Pump Well
(Flowing well, pump well, infiltration trench, or tunnel)
- 2. Location is: 1/4 mi. S.W. of Philomath Ore
(Approximate distance and direction from nearest city or town)

and is more particularly described as follows:

- (a) 561' W + 198' N from SE Cor Sec 10
(Give distance and bearing to corner of section or other legal subdivision)
- being within SE 1/4 SE 1/4 of Sec. 10, Twp. 12 S, Rge. 6 W
(Smallest legal subdivision) (S. or T.) (E. or W.)
- or (b) within limits of recorded platted property, town or city:

in Lot _____, Block _____ of _____
(If within city or town, give name) County of _____
(Name of plat or addition)

- 3. Construction Work was begun on 1953; was completed on 1953
(Date) (Date)

and the ground water claimed was first used for the purposes set out below on 1953
(Date)

since which time the water has been used continuously
(Continuously or intermittently)
from 1953 to 1958
(Date) (Date)

- 4. Quantity of water claimed and used is 20 gallons per minute; 4 acre feet per year.

- 5. Purpose or Purposes for which water is used Domestic Irrigation
(Domestic, irrigation, municipal, manufacturing, industrial, etc.)

6. Description of Well: Depth 42 feet. Type _____
(Dug or drilled)
diameter 6 inches. Elevation of ground at well site 300 feet, mean sea level.
(As near as known)
Depth to water table 15 feet.

- 7. Capacity of Well: 40 g.p.m. with 15 feet drawdown.
_____ g.p.m. with _____ feet drawdown.


Date of test _____

If Flowing Well: Measured discharge _____ g.p.m. on _____
(Date)

Shut-in pressure at ground surface _____ lbs. per sq. in. on _____
(Date)

Water is controlled by _____
(Cap, valve, etc.)

Township 12S Range 6W, W.M.
North

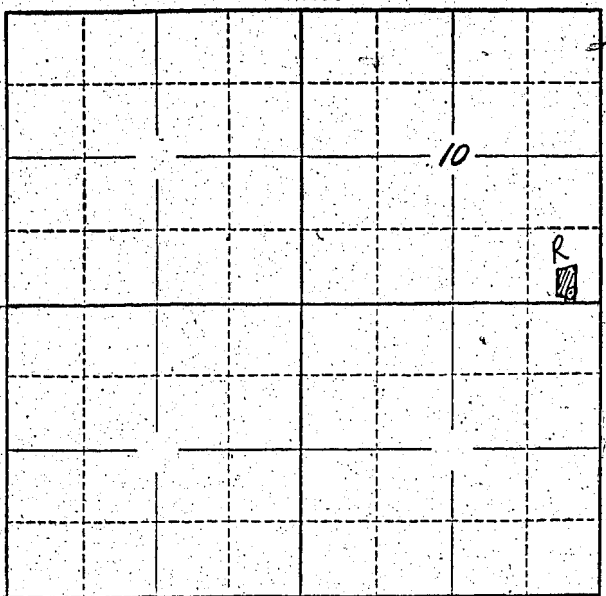

Locate well and acreage of irrigated land on plat.
Scale: 2" = 1 Mile

STATE OF OREGON

County of BENTON } ss.

I, George Neuman, being first duly sworn, do hereby certify that I have read the foregoing Registration Statement and that all of the items therein contained are true to the best of my knowledge and belief.

George Neuman
(Signature of Registrant)

Subscribed and sworn to before me this 28th day of July, 1958

My commission expires _____
(SEAL) My Commission Expires Jan. 23, 1961

Dean K. Eaton
(Notary Public)

CERTIFICATE OF REGISTRATION

STATE OF OREGON } ss.
County of Marion

This is to certify that the foregoing Registration Statement was received in the office of the State Engineer on the 30 day of July, 1958, at 8:00 o'clock A. M. and has been duly recorded in said office in Book No. 12 of Registration Statements on page GR-2948

Witness my hand this 25th day of May, 1959

Lewis A. Stanley
(State Engineer)

\$15.00

By _____ (Deputy)

GR-2948