

Registration Statement

OF CLAIMANT OF RIGHT TO APPROPRIATE GROUND WATER

TO THE STATE ENGINEER OF OREGON:

I, Fred G eschwill

of Route #2 Box 302A Woodburn, Oregon County of Marion

State of Oregon, do hereby make application for a certificate of registration as evidence of a right to appropriate ground water.

1. Source from which water is withdrawn is PUMP WELL
(Flowing well, pump well, infiltration trench, or tunnel)

2. Location is: One mile southeast of Woodburn
(Approximate distance and direction from nearest city or town)

and is more particularly described as follows: 300 ft. N. & 150 ft. west from E 1/4 corner.

(a) 1470' N. of County Road & 1420 West from East Line
(Give distance and bearing to corner of section or other legal subdivision)

being within SE 1/4 of NE 14 of Sec. 19, Twp. 5 S, Rge 1 west
(Smallest legal subdivision) (N. or S.) (E. or W.)

(b) within limits of recorded platted property, town or city:
in Lot _____, Block _____ of _____
(Name of plat or addition)

County of Marion
(If within city or town, give name)

3. Construction Work was begun on Sept 1953; was completed on May 1954
(Date) (Date)

and the ground water claimed was first used for the purposes set out below on May 1954
(Date)

since which time the water has been used May to October of each year (intermittently)
(Continuously or intermittently)

from May to October of each year
(Date) (Date)

4. Quantity of water claimed and used is 700 gallons per minute; 200 acre feet per year.

5. Purpose or Purposes for which water is used Irrigation
(Domestic, irrigation, municipal, manufacturing, industrial, etc.)

6. Description of Well: Depth 142 feet. Type Drilled
(Dug or drilled)
diameter 12 inches. Elevation of ground at well site 150 feet, mean sea level.
(As near as known)
Depth to water table 31 feet.

7. Capacity of Well: 400 g.p.m. with 44 feet drawdown.
500 g.p.m. with 50 feet drawdown.

Date of test Oct. 8, 1953

If Flowing Well: Measured discharge _____ g.p.m. on _____
(Date)

Shut-in pressure at ground surface _____ lbs. per sq. in. on _____
(Date)

Water is controlled by _____
(Cap, valve, etc.)

8. Casing: (Give diameter, commercial specifications and depth below ground surface of each casing size.)

12 inch diameter from 0 to 142 feet
 inch diameter from to feet
 inch diameter from to feet
 inch diameter from to feet

Describe and show depth of shoe, plug, adapter, liner or other details:

9. Perforated Casings or Screens:

Perforated from bottom up to 129' from to
(Number per foot and size of perforations, or describe screen)
 19 rows of 10 perforations to the row from to
 or 190 perforations from to
 from to

10. Log of Well: (Describe each stratum or formation clearly, indicate if water bearing, and give thickness and depth as indicated.)

MATERIAL	Thickness (Feet)	Depth to Bottom (Feet)

The following is a log of the formations encountered and the results obtained in pumping tests on 12" well

From top	to 30'	Top soil then yellow silt
30	to 75	Blue shale
75	to 78	Black sand
78	to 84	Blue shale
84	to 90	Brown shale
90	to 102	Blue shale
102	to 122	Sand & shale (soft)
122	to 142	Sand & Gravel (water)

(Bottom getting tight shows some shale)

Perforated with Mills Perforator from bottom up to 129' with 19 rows of 10 perforations to the row or 190 perforations.

If log of well is not available, give name and address of driller.

11. Infiltration Trench: Covered or open

Dimensions: Length _____ ft. Minimum depth _____ ft. Maximum depth _____ ft.

Bottom width _____ ft. Discharge _____ g.p.m. Date of test _____

12. Tunnel: Type of lining

Dimensions: _____
(Length, course, and cross sectional size)

Position of water bearing stratum with reference to portal of tunnel _____

Log of tunnel: (Preceding table for log of well may be used, if desired. Give footage from portal and character of materials, as pertinent.)

13. Pumping Equipment:

(a) Pump Jacuzzi - 50 H.P. Capacity 1200 g.p.m.
(Make, type and size)


(b) Motor General Electric - 50 H.P.
(Type and horsepower)

14. Location of area irrigated or to be irrigated, or place of use if for purposes other than irrigation.

Township North or South	Range E or W. of Williamsite Meridian	Section	Forty-acre Tract	Number Acres To Be Irrigated	Date of Reclamation
55	1 W	19	SW 1/4 of NE 1/4	16.6	1954
"	"	19	NW 1/4 NE 1/4	1.2	"
"	"	19	NE 1/4 NE 1/4	9.3	"
"	"	19	SE 1/4 NE 1/4	40.0	"
"	"	20	NW 1/4 NW 1/4	10.0	"
"	"	20	NE 1/4 NW 1/4	3.6	"
"	"	20	SE 1/4 NW 1/4	4.1	"
"	"	20	SW 1/4 NW 1/4	39.5	"
"	"	20	NW 1/4 SW 1/4	27.7	"
"	"	19	NE 1/4 SE 1/4	35.7	"
"	"	19	NW 1/4 SE 1/4	12.3	"
				200 ⁰⁰ Ac	

15. If the ground water supply is supplemental to an existing water supply, identification of any application for a permit, permit, certificate or adjudicated right to appropriate water made or held by the registrant.

Township 5 S Range 1 W, W.M.
North

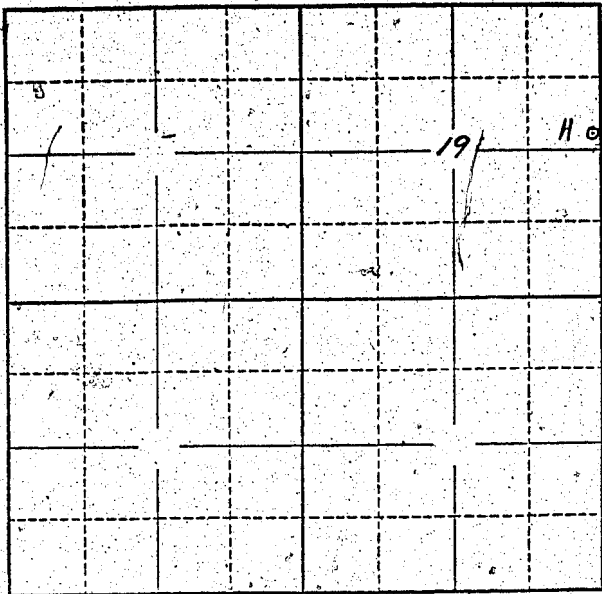

Locate well and acreage of irrigated land on plat.
Scale: 2" = 1 Mile

STATE OF OREGON }
County of _____ } ss.

I, _____, being first duly sworn, do hereby certify that I have read the foregoing Registration Statement and that all of the items therein contained are true to the best of my knowledge and belief.

Frank A. Beckwith
(Signature of Registrant)

Subscribed and sworn to before me this 28th day of July, 1958.

My commission expires September 11, 1960
Patricia A. Beckwith
(Notary Public)

(SEAL)

CERTIFICATE OF REGISTRATION

STATE OF OREGON }
County of Marion } ss.

This is to certify that the foregoing Registration Statement was received in the office of the State Engineer on the 30th day of July, 1958, at 9⁰⁰ o'clock A. M. and has been duly recorded in said office in Book No. 12 of Registration Statements on page GR-2954

Witness my hand this 25th day of May, 1959.

Lewis A. Stanley
(State Engineer)

\$ 30.50

By _____ (Deputy)

GR- 2954