

Registration Statement

OF CLAIMANT OF RIGHT TO APPROPRIATE GROUND WATER

TO THE STATE ENGINEER OF OREGON:

I, Leland G & Phyllis K Newhouse
of Route #1, Dayton County of Yamhill
(Mailing address)

State of Oregon, do hereby make application for a certificate of registration as evidence of a right to appropriate ground water.

1. Source from which water is withdrawn is Pump Well
(Flowing well, pump well, infiltration trench, or tunnel)

2. Location is: 6 miles S. with east of Dayton
(Approximate distance and direction from nearest city or town)

and is more particularly described as follows: 1000' E & 650' N from center Section 8

(a) Section of Land in John H. Thessing D.C. Claim No. 51
SW 1/4 NE 1/4
(Give distance and bearing to corner of section or other legal subdivision)

being within West of Willamette Meridian of Sec. 8, Twp. 5 South Rge. 3 West
(Smallest legal subdivision) (N. or S.) (E. or W.)

or (b) within limits of recorded platted property, town or city:

in Lot _____, Block _____ of _____
(Name of plat or addition)

County of _____
(If within city or town, give name)

3. Construction Work was begun on July 1937; was completed on July 1937
(Date) (Date)

and the ground water claimed was first used for the purposes set out below on 1937
(Date)

since which time the water has been used Continuously
(Continuously or intermittently)

from December 1937 present time
(Date) (Date)

4. Quantity of water claimed and used is 20 gallons per minute; _____ acre feet per year.

5. Purpose or Purposes for which water is used: ~~Domestic, irrigation, municipal, manufacturing, industrial, etc.~~

Also for irrigation of Nursery Stock
(Domestic, irrigation, municipal, manufacturing, industrial, etc.)

6. Description of Well: Depth 105 feet. Type Drilled
(Dug or drilled)

diameter Casing 6 inches. Elevation of ground at well site 120 feet, mean sea level.
(As near as known)

Depth to water table 15 feet.

7. Capacity of Well: _____ g.p.m. with _____ feet drawdown; } Not Tested
_____ g.p.m. with _____ feet drawdown


Date of test _____

If Flowing Well: Measured discharge _____ g.p.m. on _____
(Date)

Shut-in pressure at ground surface _____ lbs. per sq. in. on _____
(Date)

Water is controlled by _____
(Cap, valve, etc.)

Township 5S Range 2W W.M.
North

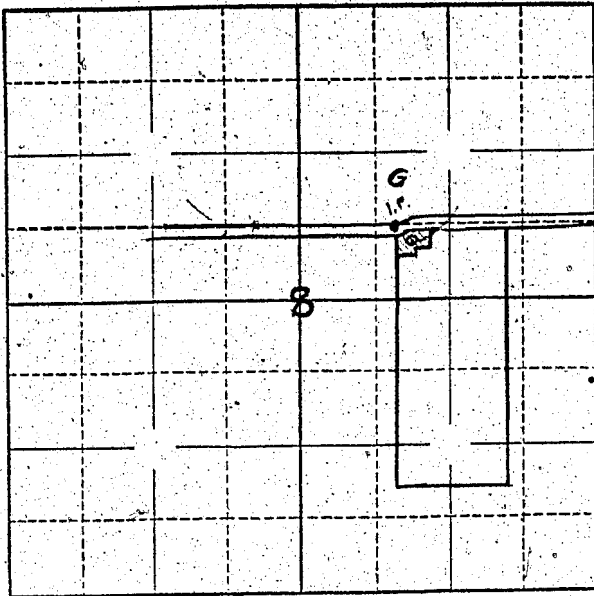

Locate well and acreage of irrigated land on plat.

Scale: $\frac{1}{2}$ " = 1 Mile

STATE OF OREGON

County of Polk } ss.

I, Thyllis K. Newhouse being first duly sworn, do hereby certify that I have read the foregoing Registration Statement and that all of the items therein contained are true to the best of my knowledge and belief.

Thyllis K. Newhouse
(Signature of Registrant)

Subscribed and sworn to before me this 30th day of July, 1958

My commission expires 12th June, 1961 Wm. S. Bartholomew
(Notary Public)

(SEAL)

CERTIFICATE OF REGISTRATION

STATE OF OREGON } ss.
County of Marion

This is to certify that the foregoing Registration Statement was received in the office of the State Engineer on the 30th day of July, 1958, at 9:15 o'clock A. M. and has been duly recorded in said office in Book No. 12 of Registration Statements on page GR-2955

Witness my hand this 25th day of May, 1959

Clara A. Stanley
(State Engineer)

By _____
(Deputy)

GR - 2955

1/5-22