

Registration Statement

OF CLAIMANT OF RIGHT TO APPROPRIATE GROUND WATER

TO THE STATE ENGINEER OF OREGON:

I, CURTIS A DOUGLAS
of RTE 1, BOX 143, DAYTON, OREGON County of YAMHILL
(Mailing address)

State of OREGON, do hereby make application for a certificate of registration as evidence of a right to appropriate ground water.

- 1. Source from which water is withdrawn is PUMP WELL (South well)
(Flowing well, pump well, infiltration trench, or tunnel)
- 2. Location is: 8 MILES S. BY S.E. OF DAYTON, OREGON
(Approximate distance and direction from nearest city or town)

and is more particularly described as follows:

(a) 2000' WEST & 900' N FROM S.E. CORNER SECTION 23
(Give distance and bearing to corner of section or other legal subdivision)
being within SW 1/4 SE 1/4 of Sec. 23, Twp. 5S, Rge. 3W
(Smallest legal subdivision) (N. or S.) (E. or W.)

or (b) within limits of recorded platted property, town or city:

in Lot _____, Block _____ of _____
(Name of plat or addition)

County of _____
(If within city or town, give name)

3. Construction Work was begun on 1936; was completed on 1936
(Date) (Date)

and the ground water claimed was first used for the purposes set out below on 1936
(Date)

since which time the water has been used INTERMITTENTLY
(Continuously or intermittently)

from MAY to OCTOBER
(Date) (Date)

4. Quantity of water claimed and used is 200 gallons per minute; 100 acre feet per year.

5. Purpose or Purposes for which water is used IRRIGATION

(Domestic, irrigation, municipal, manufacturing, industrial, etc.)

6. Description of Well: Depth 28 feet. Type DRILLED
(Dug or drilled)

diameter 8 inches. Elevation of ground at well site 95 feet, mean sea level.
(As near as known)

Depth to water table 10 feet.

7. Capacity of Well: NO TEST g.p.m. with _____ feet drawdown.

_____ g.p.m. with _____ feet drawdown.

Date of test _____

If Flowing Well: Measured discharge _____ g.p.m. on _____
(Date)

Shut-in pressure at ground surface _____ lbs. per sq. in. on _____
(Date)

Water is controlled by _____
(Cap, valve, etc.)

8. Casing: (Give diameter, commercial specifications and depth below ground surface of each casing size.)

8 inch diameter from 0 to 28 feet
..... inch diameter from to feet
..... inch diameter from to feet
..... inch diameter from to feet

Describe and show depth of shoe, plug, adapter, liner or other details:

9. Perforated Casings or Screens:

PERFORATED from ? to ?
(Number per foot and size of perforations, or describe screen)
..... from to
..... from to
..... from to

10. Log of Well: (Describe each stratum or formation clearly, indicate if water bearing, and give thickness and depth as indicated.)

MATERIAL	Thickness (Feet)	Depth to Bottom (Feet)
NOT AVAILABLE		

If log of well is not available, give name and address of driller: FRED WYMORE
SALEM, OREGON

11. Infiltration Trench: Covered or open _____
 Dimensions: Length _____ ft. Minimum depth _____ ft. Maximum depth _____ ft.
 Bottom width _____ ft. Discharge _____ g.p.m. Date of test _____

12. Tunnel: Type of lining _____
 Dimensions: _____
(Length, course, and cross sectional size)
 Position of water bearing stratum with reference to portal of tunnel _____

Log of tunnel: (Preceding table for log of well may be used, if desired. Give footage from portal and character of materials, as pertinent.)


13. Pumping Equipment:
 (a) Pump 3" F.M. CENTRIFUGAL Capacity 300 g.p.m.
(Make, type and size)
 (b) Motor 15 HP. ELECTRIC F.M.
(Type and horsepower)

14. Location of area irrigated or to be irrigated, or place of use if for purposes other than irrigation.

Township North or South	Range E. or W. of Willamette Meridian	Section	Forty-acre Tract	Number Acres To Be Irrigated	Date of Reclamation
59	3W	23	SW ¹ / ₄ SE ¹ / ₄	40	1936
"	"	"	NW ¹ / ₄ SE ¹ / ₄	18	1936
				<u>58.0 Ac</u>	

15. If the ground water supply is supplemental to an existing water supply, identification of any application for a permit, permit, certificate or adjudicated right to appropriate water made or held by the registrant.
None

Township 5S Range 3W, W.M.
North

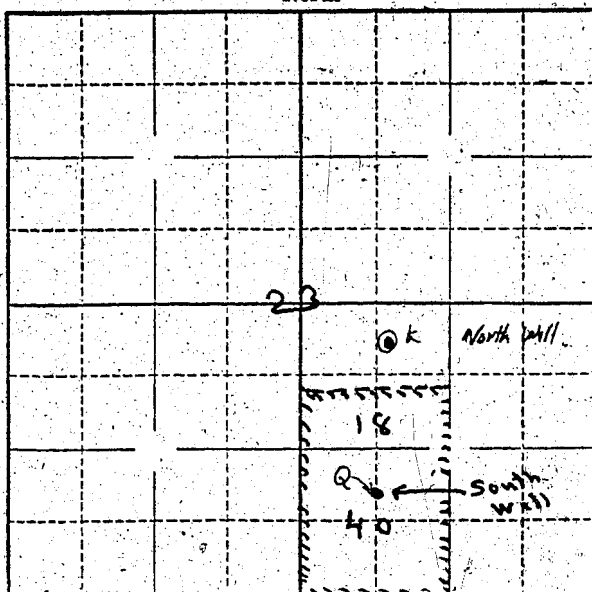

Locate well and acreage of irrigated land on plat.

Scale: ~~1/2~~ - 1 Mile
40

STATE OF OREGON

County of Marion } ss.

I, Curtis A. Douglas, being first duly sworn, do hereby certify that I have read the foregoing Registration Statement and that all of the items therein contained are true to the best of my knowledge and belief.

Curtis A. Douglas
(Signature of Registrant)

Subscribed and sworn to before me this 30th day of July, 1958.

My commission expires Sept. 8, 1960

Shirley F. Wheeler
(Notary Public)

(SEAL)

CERTIFICATE OF REGISTRATION

STATE OF OREGON

County of Marion } ss.

This is to certify that the foregoing Registration Statement was received in the office of the State Engineer on the 30th day of July, 1958, at 9⁰⁰ o'clock A M. and has been duly recorded in said office in Book No. 13 of Registration Statements on page GR-2962

Witness my hand this 2nd day of June, 1959.

Henry A. Stanley
(State Engineer)

By _____ (Deputy)

GR-2962

#19.20