

REGISTRATION STATEMENT
STATE ENGINEER
SALEM, OREGON

Registration No. GR 3159
Certificate No. GR 2958

Registration Statement

No Fee ↑

OF CLAIMANT OF RIGHT TO APPROPRIATE GROUND WATER

TO THE STATE ENGINEER OF OREGON:

I, Marjorie G. McBride, Supt., Hillcrest School of Oregon

of 2150 Strong Rd., Salem, Oregon County of Marion

State of Oregon, do hereby make application for a certificate of registration as evidence of a right to appropriate ground water.

1. Source from which water is withdrawn is Pump well
(Flowing well, pump well, infiltration trench, or tunnel)

2. Location is: 1 Miles SSE of Salem
(Approximate distance and direction from nearest city or town)

and is more particularly described as follows:

(a) 420 feet east & 610 feet south from NW corner Section 12
(Give distance and bearing to corner of section or other legal subdivision)

being within NW 1/4 of NW 1/4 of Sec. 12 Twp. 8S Rge. 3W
(Smallest legal subdivision) (N or S) (E or W)

or (b) within limits of recorded platted property, town or city:

in Lot _____ Block _____ of _____
(Name of plat or addition)

County of _____
(If within city or town, give name)

3. Construction Work was begun on Prior to 1932; was completed on Prior to 1932
(Date) (Date)

and the ground water claimed was first used for the purposes set out below on Prior to 1932
(Date)

since which time the water has been used Continuously
(Continuously or intermittently)

from Prior to 1932 to Oct. 1957
(Date) (Date)

4. Quantity of water claimed and used is 300 gallons per minute; _____ acre feet per year.

5. Purpose or Purposes for which water is used Domestic and irrigation
(Domestic, irrigation, municipal, manufacturing, industrial, etc.)

6. Description of Well: Depth 302 feet. Type Drilled
(Dug or drilled)

diameter 12 inches. Elevation of ground at well site 250 feet, mean sea level.
(As near as known)

Depth to water table 12 feet.

7. Capacity of Well: 220 g.p.m. with 26 feet drawdown.

340 g.p.m. with 42 feet drawdown.


Date of test October 16, 1954

If Flowing Well: Measured discharge _____ g.p.m. on _____
(Date)

Shut-in pressure at ground surface _____ lbs. per sq. in. on _____
(Date)

Water is controlled by _____
(Cap, valve, etc.)

Township 5 South Range 3 West, W.M.
North

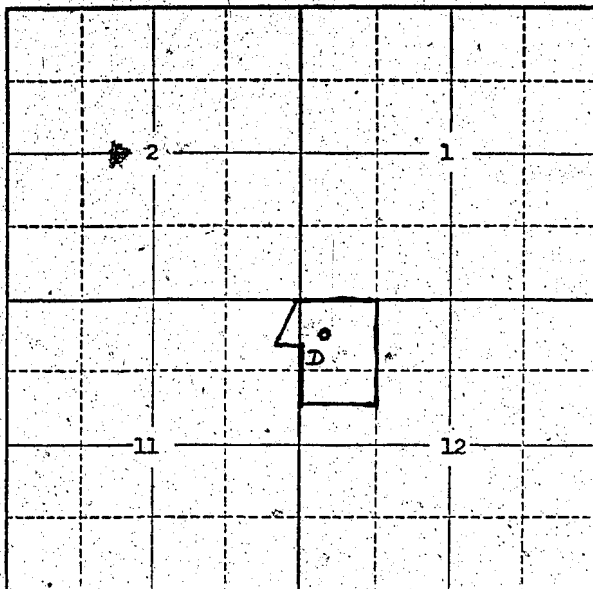

Locate well and acreage of irrigated land on plat
Scale: 2" = 1 Mile

* Well

STATE OF OREGON

County of Marion

ss.

I, Marjorie G. McBride, Supt., being first duly sworn, do hereby certify that I have read the foregoing Registration Statement and that all of the items therein contained are true to the best of my knowledge and belief.

Marjorie G. McBride
(Signature of Registrant)

Subscribed and sworn to before me this 2nd day of June, 1958

My commission expires July 14, 1961

Delbert S. Seeger
(Notary Public)

(SEAL)

CERTIFICATE OF REGISTRATION

STATE OF OREGON

County of Marion

ss.

This is to certify that the foregoing Registration Statement was received in the office of the State Engineer on the 4th day of August, 1958, at 9:30 o'clock A.M. and has been duly recorded in said office in Book No. 12 of Registration Statements on page GR-2958.

Witness my hand this 25th day of May, 1959

Laura A. Stanley
(State Engineer)

By _____ (Deputy)

\$725

GR - 2958