

Registration Statement

REGISTRATION NO. GR-316CERTIFICATE NO. CR-297

OF CLAIMANT OF RIGHT TO APPROPRIATE GROUND WATER

(Under Chapter 708, Oregon Laws 1955.)

TO THE STATE ENGINEER OF OREGON:

I, Orin S. Rice RT 1, Box 44
of Mount Angel County of Clackamas

State of Oregon, do hereby make application for a certificate of registration as evidence of a right to appropriate ground water.

1. Source from which water is withdrawn is pump well
(Flowing well, pump well, infiltration trench, or tunnel)

2. Location is: 1/4 mi. S.W. of Marquam, Oregon
(Approximate distance and direction from nearest city or town)

and is more particularly described as follows:

(a) 145 rods West and 47.5 rods South of the N.E. corner of Sec. 9
(Give distance and bearing to corner of section or other legal subdivision)

being within NW 1/4 of the NE 1/4 of Sec. 9, Twp. 6 S, Rge. 1 E
(Smallest legal subdivision) (N. or S.) (E. or W.)

or within limits of recorded platted property, town or city:

in Lot _____, Block _____ of _____
(Name of plat or addition)

County of _____

(If within city or town, give name)

3. Construction Work was begun on about Dec. 1, 1951; was completed on Dec. 14, 1951
(Date) (Date)

and the ground water claimed was first used for the purposes set out below on about June 1, 1952
(Date)

since which time the water has been used intermittently
(Continuously or Intermittently)

from 6/1/52 to Present time (Dec. 1954)
(Date) (Date)

4. Quantity of water claimed and used is 80 gallons per minute; _____ acre feet per year.

5. Purpose or Purposes for which water is used _____

Domestic and irrigation
(Domestic, irrigation, municipal, manufacturing, industrial, etc.)

6. Description of Well: Depth 95 feet. Type drilled
(Dug or drilled)

diameter 6 inches. Elevation of ground at well site 310 feet, mean sea level.
(As near as known)

Depth to water table 12 feet.

7. Capacity of Well: 80 g.p.m. with 76 feet drawdown.

_____ g.p.m. with _____ feet drawdown.


Date of test Dec. 14, 1951

If Flowing Well: Measured discharge _____ g.p.m. on _____
(Date)

Shut-in pressure at ground surface _____ lbs. per sq. in. on _____
(Date)

Water is controlled by _____
(Cap, valve, etc.)

Township 6 S Range 1 E W.M.
North

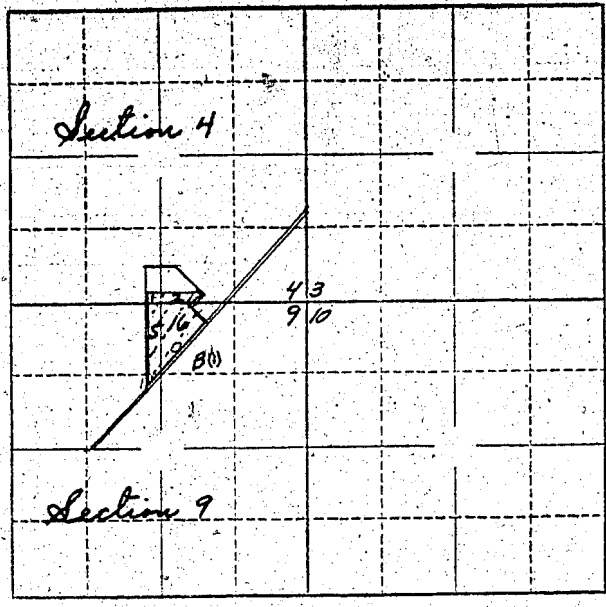

Locate well and acreage of irrigated land on plat.
Scale: 2" = 1 Mile

STATE OF OREGON

County of Marion } ss.

I, Orrin S. Rice, being first duly sworn, do hereby certify that I have read the foregoing Registration Statement and that all of the items therein contained are true to the best of my knowledge and belief.

Orrin S. Rice
(Signature of Registrant)

Subscribed and sworn to before me this 17 day of December, 1956

My commission expires 9/27/58

Jeanie Bayter
(Notary Public)

(SEAL)

CERTIFICATE OF REGISTRATION

STATE OF OREGON

County of Marion } ss.

This is to certify that the foregoing Registration Statement was received in the office of the State Engineer on the 17th day of December, 1956, at 9:30 o'clock A. M. and has been duly recorded in said office in Book No. 2 of Registration Statements on page GR-297-C

~~Consent to the recording of this statement is hereby given by the registrant and the owner of the land described herein and the same is hereby acknowledged to be true and correct.~~

Witness my hand this 15th day of January, 1957

Clarence A. Stanley
(State Engineer)

By _____
(Deputy)

GR-297C