

Registration Statement

REGISTRATION NO. GR-3160

CERTIFICATE NO. GR-2959

OF CLAIMANT OF RIGHT TO APPROPRIATE GROUND WATER

(Under Chapter 708, Oregon Laws 1955.)

TO THE STATE ENGINEER OF OREGON:

I, DON E. KELSEY

of The Dalles County of Wasco

State of Oregon, do hereby make application for a certificate of registration as evidence of a right to appropriate ground water.

1. Source from which water is withdrawn is Pump well

(Flowing well, pump well, infiltration trench, or tunnel)

2. Location is: within Dalles City, Oregon

(Approximate distance and direction from nearest city or town)

and is more particularly described as follows:

(a) 1130 feet West and 705 feet South of the center of Section 4,

(Give distance and bearing to corner of section or other legal subdivision)

being within NELSW of Sec. four, Twp. 1 North, Rge. 13 East, W.M.

(Smallest legal subdivision)

(N. or S.)

(E. or W.)

or (b) within limits of recorded platted property, town or city:

in Lot L, Block 94 of DALLES MILITARY RESERVATION

(Name of plat or addition)

The Dalles County of Wasco

(If within city or town, give name)

3. Construction Work was begun on 1909 or 1910

(Date)

believe about

1909 or 1910

(Date)

and the ground water claimed was first used for the purposes set out below on believe about 1909 or 1910

(Date)

since which time the water has been used intermittently

(Continuously or intermittently)

from about 1910 to date

(Date)

(Date)

4. Quantity of water claimed and used is 20 gallons per minute; acre feet per year.

5. Purpose or Purposes for which water is used domestic and irrigation

(Domestic, irrigation, municipal, manufacturing, industrial, etc.)

6. Description of Well: Depth 184 feet. Type Drilled

(Dug or drilled)

diameter five inches. Elevation of ground at well site 150 feet, mean sea level.

(As near as known)

Depth to water table approx. 30 feet.

7. Capacity of Well: 20 g.p.m. with 10 feet drawdown.

2 g.p.m. with feet drawdown.

Date of test

If Flowing Well: Measured discharge g.p.m. on

(Date)

Shut-in pressure at ground surface lbs. per sq. in. on

(Date)

Water is controlled by

(Cap, valve, etc.)

size.)

			from	to	feet
5	inch diameter	steel pipe casing	from top of	ground	
	inch diameter		from	to	feet
	inch diameter		from	to	feet
	inch diameter		from	to	feet

Describe and show depth of shoe, plug, adapter, liner or other details: Cylinder down 1 1/2

9. Perforated Casings or Screens.

(Number per foot and size of perforations, or describe screen)

	from	to
	from	to
	from	to
	from	to

[illegible]

GR-2959

If log of well is not available, give name and address of driller. Mr. Kretzer address not known

11. Infiltration Trench: Covered or open

Dimensions: Length ft. Minimum depth ft. Maximum depth ft.

Bottom width ft. Discharge g.p.m. Date of test

12. Tunnel: Type of lining _____

Dimensions: _____ (Length, course, and cross sectional size)

Position of water bearing stratum with reference to portal of tunnel

Log of tunnel: (Preceding table for log of well may be used, if desired. Give footage from portal and character of materials, as pertinent.)

13. Pumping Equipment:

(a) Pump Electric 2 hp Capacity 20 g.p.m.
(Make, type and use)

(b) Motor _____
(Type and horsepower)

14. Location of area irrigated or to be irrigated, or place of use if for purposes other than irrigation.


[illegible]

15. If the ground water supply is supplemental to an existing water supply, identification of any application for a permit, permit, certificate or adjudicated right to appropriate water made or held by the registrant.

GR 2959

(North Half of Block 94, Dallas Military Reservation)

Township 1 North Range 13 East, W.M.
North

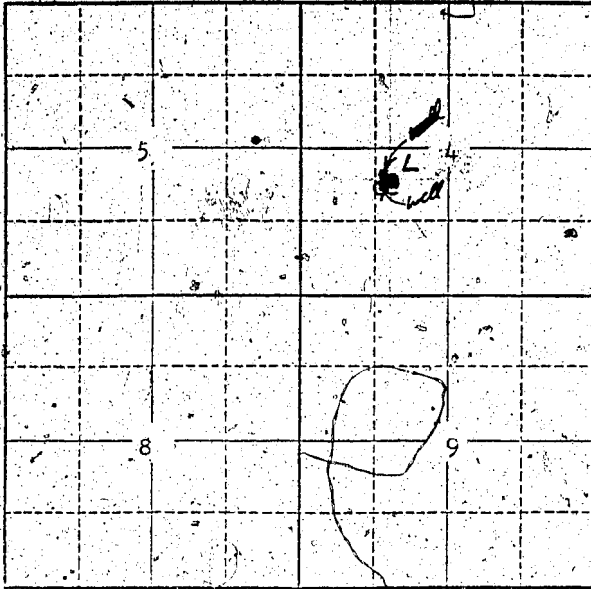

Well

Note: Shaded area
is area to be
irrigated.

Locate well and acreage of irrigated land on plat.

Scale: 2" = 1 Mile

STATE OF OREGON Wasco
County of ~~Wasco~~ **Wasco** ss.

I, Don E. Kelsey, being first duly sworn, do hereby certify that I have read the foregoing Registration Statement and that all of the items therein contained are true to the best of my knowledge and belief.

Don E. Kelsey
(Signature of Registrant)

Subscribed and sworn to before me this 28th day of July, 1958.

My commission expires January 15, 1962.

Ronald E. Hulse
(Notary Public)

(SEAL)

CERTIFICATE OF REGISTRATION

STATE OF OREGON ss.
County of Marion

This is to certify that the foregoing Registration Statement was received in the office of the State Engineer on the 30 day of July, 1958, at 11:30 o'clock A.M. and has been duly recorded in said office in Book No. 12 of Registration Statements on page GR 2959.

~~xx Construction shall be completed by the date of the expiration of the term of the certificate of registration.~~
~~xx~~

Witness my hand this 25th day of May, 1959.

Lewis A. Stanley
(State Engineer)

By GR 2959

(Deputy)