

Registration Statement

OF CLAIMANT OF RIGHT TO APPROPRIATE GROUND WATER

TO THE STATE ENGINEER OF OREGON:

I, Jessie Reese (MC Knight Place)
 of Milton Freewater, P.O. Box 33A County of Umatilla
 State of Oregon, do hereby make application for a certificate of registration as evidence
 of a right to appropriate ground water.

1. Source from which water is withdrawn is Pump Well #1
(Flowing well, pump well, infiltration trench, or tunnel)
 2. Location is: 3 miles NW Milton Freewater
(Approximate distance and direction from nearest city or town)

and is more particularly described as follows:

- (a) a pt. 10' N. from pt. 20' N. from SE Cor. NW 1/4 NE 1/4 Sec. 34
(Give distance and bearing to corner of section or other legal subdivision) Tp. 6 N. R. 35 E. W. 1 M
 being within NE 1/4 NW 1/4 of Sec. 34, Twp. 6 N, Rge. 35 E
(Smallest legal subdivision) (N or S) (E or W)
 or (b) within limits of recorded platted property, town or city:

in Lot _____, Block _____ of _____
(Name of plat or addition)
 County of Umatilla
(If within city or town, give name)

3. Construction Work was begun on Feb. 1912; was completed on Apr. 1912
(Date) (Date)
 and the ground water claimed was first used for the purposes set out below on May 1, 1912
(Date)
 since which time the water has been used Continuously
(Continuously or intermittently)
 from May 1, 1912 to May 1, 1955
(Date) (Date)

4. Quantity of water claimed and used is 250 gallons per minute; 40 acre
 feet per year.

5. Purpose or Purposes for which water is used irrigation

6. Description of Well: Depth 50 feet. Type Dug
(Domestic, irrigation, municipal, manufacturing, industrial, etc.) (Dug or drilled)
 diameter 60x60 inches. Elevation of ground at well site 850 feet, mean sea level.
(As near as known)
 Depth to water table 20 feet. May 1st

7. Capacity of Well: 250 g.p.m. with _____ feet drawdown.
 _____ g.p.m. with _____ feet drawdown.

Date of test None known of

If Flowing Well: Measured discharge Not Flowing g.p.m. on _____
(Date)

Shut-in pressure at ground surface _____ lbs. per sq. in. on _____
(Date)

Water is controlled by _____
(Cap, valve, etc.)

60" x 60" inch diameter Concrete Curb from 0 to 15 feet

inch diameter _____ from _____ to _____ feet

inch diameter _____ from _____ to _____ feet

inch diameter _____ from _____ to _____ feet


9. Perforated Casings or Screens:

(Number per foot and size of perforations, or describe screen)	from	to
	from	to
	from	to
	from	to
	from	to

[illegible]

Township 6N Range 35E, W.M.

~~poor irrigation~~ North

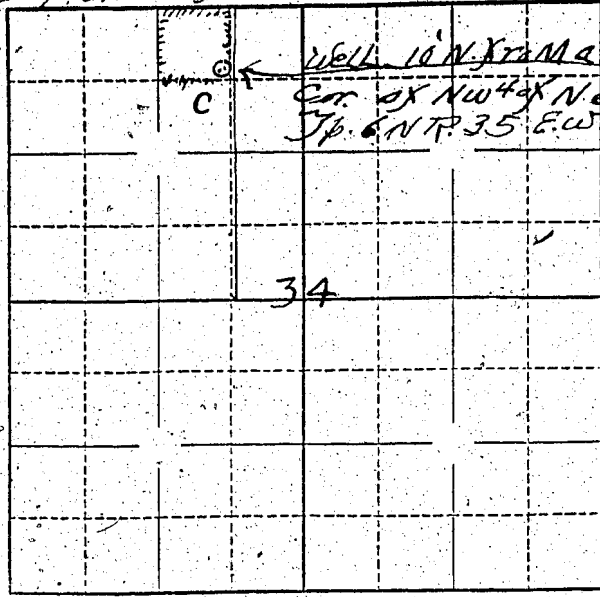

Locate well and acreage of irrigated land on plat.

Scale: 2" = 1 Mile
4" = 1 Mile

STATE OF OREGON

County of Marion } ss.

I, Jessie Reese, being first duly sworn, do hereby certify that I have read the foregoing Registration Statement and that all of the items therein contained are true to the best of my knowledge and belief.

Jessie Reese
(Signature of Registrant)

Subscribed and sworn to before me this 24th day of July, 1955

My commission expires May 5, 1960

[Signature]
(Notary Public)

(SEAL)

CERTIFICATE OF REGISTRATION

STATE OF OREGON

County of Marion } ss.

This is to certify that the foregoing Registration Statement was received in the office of the State Engineer on the 30th day of July, 1955, at 2:00 o'clock A.M. and has been duly recorded in said office in Book No. 13 of Registration Statements on page GR-2967

Witness my hand this 2nd day of June, 1959

Lewis A. Stanley
(State Engineer)

\$15.00

By _____ (Deputy)