

Registration Statement

OF CLAIMANT OF RIGHT TO APPROPRIATE GROUND WATER

TO THE STATE ENGINEER OF OREGON:

I, George M. CLARK
of Box 57 Marion County of Marion
(Mailing address)

State of OREGON, do hereby make application for a certificate of registration as evidence of a right to appropriate ground water.

1. Source from which water is withdrawn is PUMP WELL
(Flowing well, pump well, infiltration trench, or tunnel)

2. Location is: 1/2 mile SOUTH OF MARION
(Approximate distance and direction from nearest city or town)

and is more particularly described as follows:

(a) 6.5 ch. 9 and 4 ch. W. FROM THE EAST CORNER OF SECTION 33
(Give distance and bearing to corner of section or other legal subdivision)

being within N.E. 1/4 S.E. 1/4 of Sec. 33, Twp. 9 S, Rge. 1 W.
(Smallest legal subdivision) (N. or S.) (E. or W.)

or (b) within limits of recorded platted property, town or city:

in Lot _____, Block _____ of _____
(Name of platted addition)

County of MARION
(If within city or town, give name)

3. Construction Work was begun on OCT. 15, 1945; was completed on OCT. 17, 1945
(Date) (Date)

and the ground water claimed was first used for the purposes set out below on MAY 1, 1946
(Date)

since which time the water has been used INTERMITTENTLY
(Continuously or intermittently)

from MAY 1 to OCT 15
(Date) (Date)

4. Quantity of water claimed and used is 50 gallons per minute; 38.8 acre feet per year.

5. Purpose or Purposes for which water is used IRRIGATION

(Domestic, irrigation, municipal, manufacturing, industrial, etc.)

6. Description of Well: Depth 52' feet. Type DRILLED
(Dug or drilled)

diameter 6" inches. Elevation of ground at well site 300 feet, mean sea level.
(As near as known)

Depth to water table unk feet.

7. Capacity of Well: _____ g.p.m. with _____ feet drawdown.

UNKNOWN g.p.m. with _____ feet drawdown.


Date of test _____

If Flowing Well: Measured discharge _____ g.p.m. on _____
(Date)

Shut-in pressure at ground surface _____ lbs. per sq. in. on _____
(Date)

Water is controlled by _____
(Cap, valve, etc.)

Township 9 S Range 1 W, W.M.
North

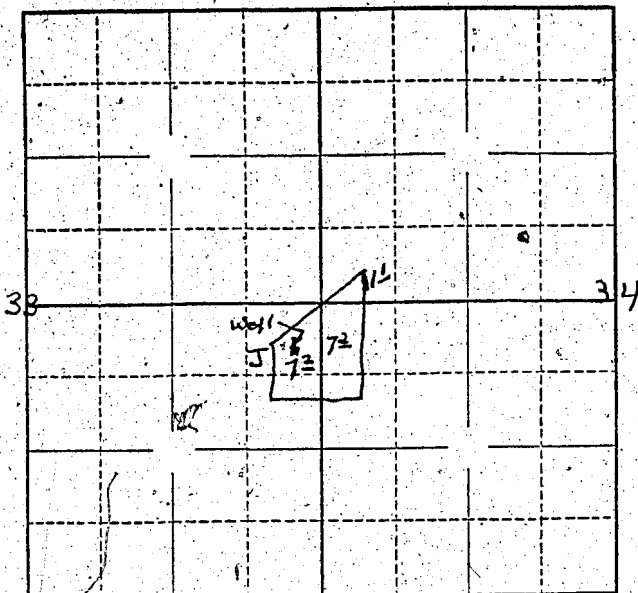

Locate well and acreage of irrigated land on plat.

Scale: $\frac{1}{4}$ - 1 Mile

STATE OF OREGON

County of Marion } ss.

I, George M Clark, being first duly sworn, do hereby certify that I have read the foregoing Registration Statement and that all of the items therein contained are true to the best of my knowledge and belief.

George M Clark
(Signature of Registrant)

Subscribed and sworn to before me this 31 day of July, 1958

My commission expires NOTARY PUBLIC FOR OREGON
My Commission Expires April 19, 1960

(Notary Public)

(SEAL)

CERTIFICATE OF REGISTRATION

STATE OF OREGON

County of Marion } ss.

This is to certify that the foregoing Registration Statement was received in the office of the State Engineer on the 30th day of July, 1958, at 10:00 o'clock A. M. and has been duly recorded in said office in Book No. 13 of Registration Statements on page GR-2969

Witness my hand this 2nd day of June, 1959

Lewis A. Stanley
(State Engineer)

\$15.00

By _____ (Deputy)