

Registration Statement

OF CLAIMANT OF RIGHT TO APPROPRIATE GROUND WATER

TO THE STATE ENGINEER OF OREGON:

I, James Reese (Home Place)
(Mailing address)

State of Oregon, do hereby make application for a certificate of registration as evidence of a right to appropriate ground water.

- 1. Source from which water is withdrawn is Pump Well
(Flowing well, pump well, infiltration trench, or tunnel)
- 2. Location is: 2 1/2 miles northwest of Milton Freewater
(Approximate distance and direction from nearest city or town)

and is more particularly described as follows:

(a) 25' W from apt 20' N from S.E. Cor. of SE 1/4 NE 1/4 NW 1/4
(Give distance and bearing to corner of section or other legal subdivision) Sec. 34, T. 6 N. R. 35 E
being within NE 1/4 NW 1/4 of Sec. 34, Twp. 6 N., Rge. 35 E. W.M.
(Smallest legal subdivision) (N. or S.) (E. or W.)

or (b) within limits of recorded platted property, town or city: _____

in Lot _____, Block _____ of _____
(Name of plat or addition)
(If within city or town, give name)

3. Construction Work was begun on Apr. 1 - 1915; was completed on June 1 - 1915
(Date) (Date)

and the ground water claimed was first used for the purposes set out below on July 1 - 1915
(Date)

since which time the water has been used Continuously
(Continuously or intermittently)

from July 1 - 1915 to Sept 1 - 1956
(Date) (Date)

4. Quantity of water claimed and used is 250 gallons per minute; 50 acre feet per year.

5. Purpose or Purposes for which water is used irrigation

(Domestic, irrigation, municipal, manufacturing, industrial, etc.)

6. Description of Well: Depth 50 feet. Type Dug
(Dug or drilled)

diameter 60 x 60 inches. Elevation of ground at well site 850 feet, mean sea level.
(As near as known)

Depth to water table 20 feet.

7. Capacity of Well: 250 g.p.m. with 40 feet drawdown.

_____ g.p.m. with _____ feet drawdown.


Date of test None

If Flowing Well: Measured discharge _____ g.p.m. on Not Flowing
(Date)

Shut-in pressure at ground surface _____ lbs. per sq. in. on _____
(Date)

Water is controlled by _____
(Cap, valve, etc.)

Township 6N Range 35E, W.M.
North

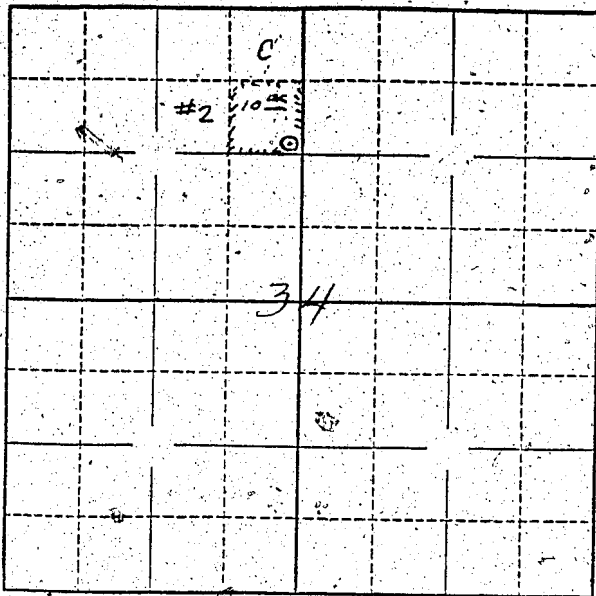

Locate well and acreage of irrigated land on plat.

Scale: $\frac{1}{4}'' = 1 \text{ Mile}$

STATE OF OREGON


I, Jessie Reese, being first duly sworn, do hereby certify that I have read the foregoing Registration Statement and that all of the items therein contained are true to the best of my knowledge and belief.

Jessie Reese
(Signature of Registrant)

Subscribed and sworn to before me this 25th day of July, 1958

My commission expires Aug 5, 1960
W. A. Lamberson
(Notary Public)

(SEAL)

CERTIFICATE OF REGISTRATION

STATE OF OREGON } ss.
County of Marion

This is to certify that the foregoing Registration Statement was received in the office of the State Engineer on the 30th day of July, 1958, at 11.30 o'clock A.M. and has been duly recorded in said office in Book No. 13 of Registration Statements on page GR-2971

Witness my hand this 2nd day of June, 1959

\$15.00

Lewis A. Stanley
(State Engineer)

By _____ (Deputy)