

# Registration Statement

## OF CLAIMANT OF RIGHT TO APPROPRIATE GROUND WATER

TO THE STATE ENGINEER OF OREGON:

I, Pacific Power & Light Company  
of Public Service Building, Portland 4, Oregon County of Multnomah  
(Mailing address)

State of Oregon, do hereby make application for a certificate of registration as evidence of a right to appropriate ground water.

1. Source from which water is withdrawn is Well field (See attached drwg B-391 & P-150)  
(Flowing well, pump well, infiltration trench, or tunnel)

2. Location is: One mile Southwest Independence, Oregon  
(Approximate distance and direction from nearest city or town)

and is more particularly described as follows: Southwest corner well property S 12° 31' West 904.00 ft. from intersection of South line of "I" Street and East line SP RR right of way

(a) Block 19, Hill's Addition to Hill's Independence  
(Give distance and bearing to corner of section or other legal subdivision)

being within NE 1/4 SW 1 of Sec. 28, Twp. 2 S, Rge. 1 W  
(Smallest legal subdivision) (N. or S.) (E. or W.)

or (b) within limits of recorded platted property, town or city:

in Lot \_\_\_\_\_, Block \_\_\_\_\_ of \_\_\_\_\_  
(Name of plat or addition)

County of Polk  
(If within city or town, give name)

3. Construction Work was begun on August 2, 1951; was completed on Sept. 26, 1951  
(Date) (Date)

and the ground water claimed was first used for the purposes set out below on September 25, 1951  
(Date)

since which time the water has been used Intermittently  
(Continuously or Intermittently)

from Sept. 26, 1951 to present date  
(Date) (Date)

4. Quantity of water claimed and used is 250 gallons per minute; \_\_\_\_\_ acre feet per year.

5. Purpose or Purposes for which water is used Municipal supply for City of Independence, Oregon  
(Domestic, irrigation, municipal, manufacturing, industrial, etc.)

6. Description of Well: Depth 71' 5" feet. Type Drilled  
(Dug or drilled)

diameter 12 inches. Elevation of ground at well site 140 feet, mean sea level.  
(As near as known)

Depth to water table 45 feet.

7. Capacity of Well: 244 g.p.m. with 8 feet drawdown.

472 g.p.m. with 20 feet drawdown.

Date of test September 30, 1957

If Flowing Well: Measured discharge \_\_\_\_\_ g.p.m. on \_\_\_\_\_  
(Date)

Shut-in pressure at ground surface \_\_\_\_\_ lbs. per sq. in. on \_\_\_\_\_  
(Date)

Water is controlled by \_\_\_\_\_  
(Cap, Valve, etc.)

8. **Casing:** (Give diameter, commercial specifications and depth below ground surface of each casing size.)

12 inch diameter ..... from 0 to 71.5 feet  
 ..... inch diameter ..... from ..... to ..... feet  
 ..... inch diameter ..... from ..... to ..... feet  
 ..... inch diameter ..... from ..... to ..... feet

Describe and show depth of shoe, plug, adapter, liner or other details: .....

9. **Perforated Casings or Screens:**

6 rows 1/2" x 12" ..... from 30 to 60  
 (Number per foot and size of perforations, or describe screen)  
 ..... from ..... to .....  
 ..... from ..... to .....  
 ..... from ..... to .....

10. **Log of Well:** (Describe each stratum or formation clearly, indicate if water bearing, and give thickness and depth as indicated.)

MATERIAL	Thickness (Feet)	Depth to Bottom (Feet)
0 - 2 Topsoil	2	
2 - 30 Brown clay	28	
30 - 70 Sand and gravel	40	
70 - 71.5 Blue clay	1.5	

If log of well is not available, give name and address of driller. Art Clinton, Route 1, Box 2,

Independence, Oregon

11. Infiltration Trench: Covered or open .....

Dimensions: Length ..... ft. Minimum depth ..... ft. Maximum depth ..... ft.

Bottom width ..... ft. Discharge ..... g.p.m. Date of test .....

12. Tunnel: Type of lining .....

Dimensions: .....  
(Length, course, and cross sectional size)

Position of water bearing stratum with reference to portal of tunnel .....

Log of tunnel: (Preceding table for log of well may be used, if desired. Give footage from portal and character of materials, as pertinent.)

**13. Pumping Equipment:**

(a) Pump Pomona Turbine - 7 MC Capacity 250 g.p.m.  
(Make, type and size)


(b) Motor 10 HP Electric motor  
(Type and horsepower)

14. Location of area irrigated or to be irrigated, or place of use if for purposes other than irrigation.

Township North or South	Range E. or W. of Willamette Meridian	Section	Forty-acre Tract	Number Acres To Be Irrigated Municipal supply	Date of Reclamation
8 S	4 W	21	E $\frac{1}{2}$ SW $\frac{1}{4}$	All	1951
8 S	4 W	28	NW $\frac{1}{4}$	All	"
8 S	4 W	29	E $\frac{1}{2}$ NE $\frac{1}{4}$	All	"

15. If the ground water supply is supplemental to an existing water supply, identification of any application for a permit, permit, certificate or adjudicated right to appropriate water made or held by the registrant.

Township 8.5 Range 4W, W.M.  
North

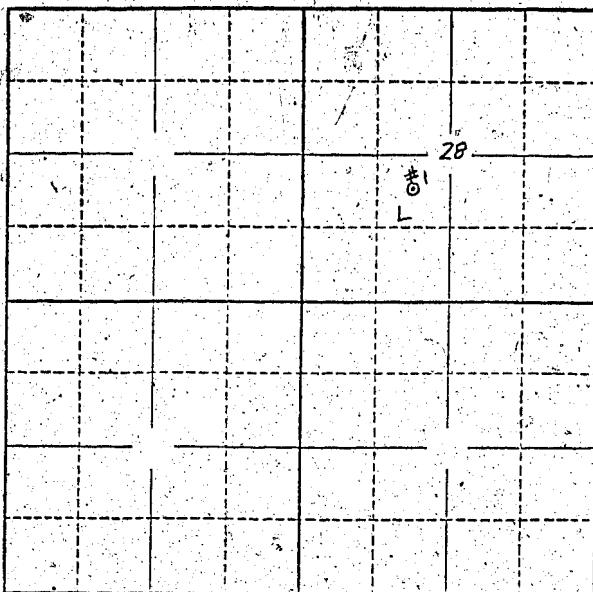

Locate well and acreage of irrigated land on plat.  
Scale: 2" = 1 Mile

STATE OF OREGON

County of Multnomah } ss.

I, A. W. Trimble, being first duly sworn, do hereby certify that I have read the foregoing Registration Statement and that all of the items therein contained are true to the best of my knowledge and belief.

PACIFIC POWER & LIGHT COMPANY

By [Signature]  
(Signature of Registrant) Vice president

Subscribed and sworn to before me this 25th day of July, 1958.

My commission expires Sept 15, 1956

[Signature]  
(Notary Public)

(SEAL)

CERTIFICATE OF REGISTRATION

STATE OF OREGON

County of Marion } ss.

This is to certify that the foregoing Registration Statement was received in the office of the State Engineer on the 30th day of July, 1958, at 8:00 o'clock A. M. and has been duly recorded in said office in Book No. 13 of Registration Statements on page GR-3141.

Witness my hand this 16th day of June, 1959

\$ 20.00

[Signature]  
(State Engineer)

By \_\_\_\_\_  
(Deputy)

GR - 3141