

Registration Statement

OF CLAIMANT OF RIGHT TO APPROPRIATE GROUND WATER

TO THE STATE ENGINEER OF OREGON:

I, Pacific Power & Light Company
of Public Service Building, Portland 4 County of Multnomah
(Mailing address)

State of Oregon, do hereby make application for a certificate of registration as evidence of a right to appropriate ground water.

Ring Well # 2

1. Source from which water is withdrawn is Well Field (See attached Drwg B-391 & P-156)
(Flowing well, pump well, infiltration trench, or tunnel)

2. Location is: One mile Southwest Independence, Oregon
(Approximate distance and direction from nearest city or town)

and is more particularly described as follows: Southwest corner well property S 12° 30' West 804.00 ft. from intersection of South line of "I" Street and East line SP RR right of way.

(a) Block 19, Hill's Addition to Hill's Independence
(Give distance and bearing to corner of section or other legal subdivision)

being within NE 1/4 SW 1 of Sec. 26 Twp. B.S. Rge. R.W.
(Smallest legal subdivision) (N. or S.) (E. or W.)

or (b) within limits of recorded platted property, town or city:

in Lot _____ Block _____ of _____
(Name of plat or addition)

County of Polk
(If within city or town, give name)

3. Construction Work was begun on Sept. 15, 1951, was completed on Sept. 26, 1951
(Date) (Date)

and the ground water claimed was first used for the purposes set out below on Sept. 28, 1951
(Date)

since which time the water has been used Intermittently
(Continuously or Intermittently)

from 9/28/51 to present date
(Date) (Date)

4. Quantity of water claimed and used is 400 gallons per minute; _____ acre feet per year.

5. Purpose or Purposes for which water is used municipal supply for City of Independence, Oregon
(Domestic, irrigation, municipal, manufacturing, industrial, etc.)

6. Description of Well: Depth 78 feet. Type DRILLED
(Dug or drilled)
diameter 12 inches. Elevation of ground at well site 140 feet, mean sea level.
(As near as known)
Depth to water table 45 feet.

7. Capacity of Well: 320 g.p.m. with 15 feet drawdown.
_____ g.p.m. with _____ feet drawdown.


Date of test _____

If Flowing Well: Measured discharge _____ g.p.m. on _____
(Date)

Shut-in pressure at ground surface _____ lbs. per sq. in. on _____
(Date)

Water is controlled by _____
(Cap, valve, etc.)

Township 85 Range 4W, W.M.
North

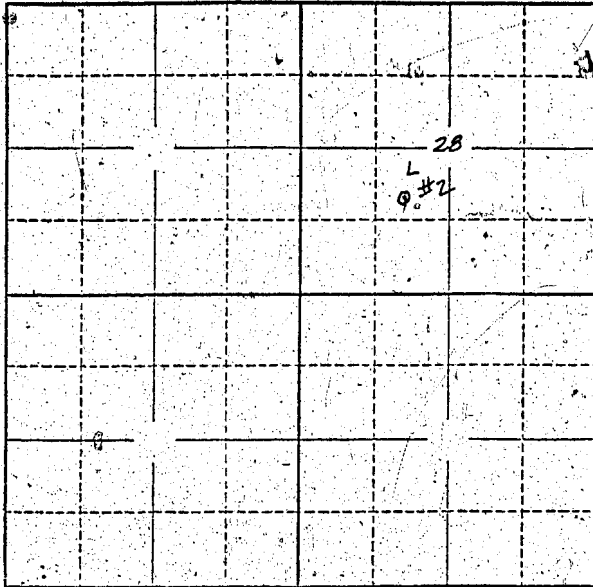

Locate well and acreage of irrigated land on plat.
Scale: 2" = 1 Mile

STATE OF OREGON

County of Multnomah } ss.

I, A. W. Trimble, being first duly sworn, do hereby certify that I have read the foregoing Registration Statement and that all of the items therein contained are true to the best of my knowledge and belief.

PACIFIC POWER & LIGHT COMPANY

By [Signature]
(Signature of Registrant) VICE PRESIDENT

Subscribed and sworn to before me this 25th day of July, 1958

My commission expires Sept. 15, 1960 [Signature]
(Notary Public)

(SEAL)

(175)

CERTIFICATE OF REGISTRATION

STATE OF OREGON

County of Marion } ss.

This is to certify that the foregoing Registration Statement was received in the office of the State Engineer on the 30th day of July, 1958, at 9:00 o'clock A. M. and has been duly recorded in said office in Book No. 13 of Registration Statements on page GR-3142

Witness my hand this 16th day of June, 1959

[Signature]
(State Engineer)

By _____
(Deputy)

GR - 3142

2000