

Registration Statement

OF CLAIMANT OF RIGHT TO APPROPRIATE GROUND WATER

TO THE STATE ENGINEER OF OREGON:

I, Pacific Power & Light Company

of Public Service Building, Portland 4 County of Multnomah
(Mailing address)

State of Oregon, do hereby make application for a certificate of registration as evidence of a right to appropriate ground water.

1. Source from which water is withdrawn is Well field (See attached drwg. B-391 & P-155)
(Flowing well, pump well, infiltration trench, or tunnel)

2. Location is: One mile Southwest Independence, Oregon
(Approximate distance and direction from nearest city or town)

and is more particularly described as follows: Southwest corner well property S 12° 30' W. 804.00 ft. from intersection of South line of "I" Street and East line SP RR right of way,

(a) Block 19, Hills Addition to Hill's Independence
(Give distance and bearing to corner of section or other legal subdivision)

being within SW1 of Sec. 28, Twp. 28, Rge. 4W
(Smallest legal subdivision) (N. or S.) (E. or W.)

or (b) within limits of recorded platted property, town or city:

in Lot _____, Block _____ of _____
(Name of plat or subdivision)

County of Polk
(If within city or town, give name)

3. Construction Work was begun on March 25, 1953; was completed on April 2, 1953
(Date) (Date)

and the ground water claimed was first used for the purposes set out below on _____
(Date)

since which time the water has been used Intermittently
(Continuously or Intermittently)

from April 2, 1953 to present date
(Date) (Date)

4. Quantity of water claimed and used is 400 gallons per minute; _____ acre feet per year.

5. Purpose or Purposes for which water is used Municipal supply for City of Independence, Oregon
(Domestic, irrigation, municipal, manufacturing, industrial, etc.)

6. Description of Well: Depth 84 feet, Type Drilled
(Dug or drilled)

diameter 12 inches. Elevation of ground at well site 140 feet, mean sea level.
(As near as known)

Depth to water table 45 feet.

7. Capacity of Well: 300 g.p.m. with 15 feet drawdown.

_____ g.p.m. with _____ feet drawdown.

Date of test _____


If Flowing Well: Measured discharge 5 g.p.m. on _____
(Date)

Shut-in pressure at ground surface, _____ lbs. per sq. in. on _____
(Date)

Water is controlled by _____
(Cap. valve, etc.)

Township 8S Range 4W W.M.

North

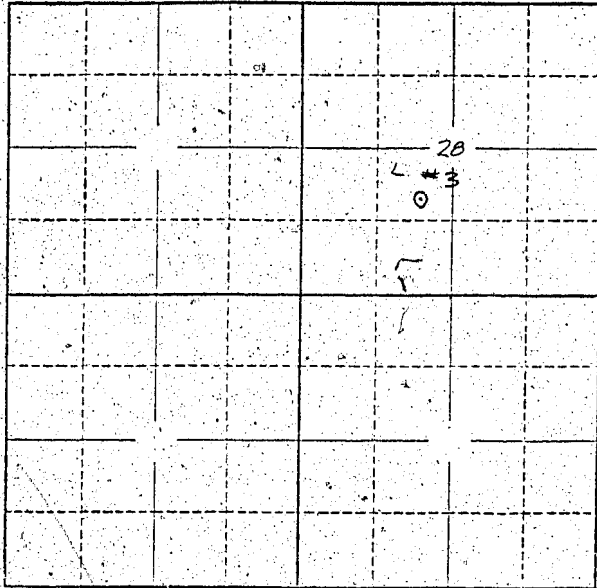

Locate well and acreage of irrigated land on plat:

Scale: 2" = 1 Mile

STATE OF OREGON

County of _____

} ss.

I, _____, being first duly sworn, do hereby certify that I have read the foregoing Registration Statement and that all of the items therein contained are true to the best of my knowledge and belief.

[Handwritten Signature]

(Signature of Registrant)

Subscribed and sworn to before me this _____ day of _____, 19____

My commission expires _____

(Notary Public)

(SEAL)

CERTIFICATE OF REGISTRATION

STATE OF OREGON

County of Marion

} ss.

This is to certify that the foregoing Registration Statement was received in the office of the State Engineer on the _____ day of _____, 19____, at _____ o'clock _____ M. and has been duly recorded in said office in Book No. 13 of Registration Statements on page GR-211

Witness my hand this 16th day of June, 1959

\$20.00

[Handwritten Signature]

(State Engineer)

By _____

(Deputy)

GR - 3143