

Registration No. GR - 3186

Certificate No. GR. 4049

Registration Statement

RECEIVED
APR 1 1950
STATE ENGINEER
SALEM, OREGON

OF CLAIMANT OF RIGHT TO APPROPRIATE GROUND WATER

TO THE STATE ENGINEER OF OREGON:

I, GUY MATHEWS
of 9582 MCKENZIE Highway County of LANE
(Mailing address)

State of ORE, do hereby make application for a certificate of registration as evidence of a right to appropriate ground water.

1. Source from which water is withdrawn is PUMP WELL
(Flowing well, pump well, infiltration trench, or tunnel)

2. Location is: _____
(Approximate distance and direction from nearest city or town)

and is more particularly described as follows:

(a) About 970 feet South & 685 feet east from N. 1/4 corner Section 31
(Give distance and bearing to corner of section or other legal subdivision)

being within NW 1/4 of NE 1/4 of Sec. 31, Twp. 17S, Rge. 1W
(Smallest legal subdivision) (S. or S.) (E. or W.)

or (b) within limits of recorded platted property, town or city: _____

in Lot _____ Block _____ of _____
SPRINGFIELD LANE County of LANE
(If within city or town, give name) (Name of plat or addition)

3. Construction Work was begun on 1950; was completed on 1950
(Date) (Date)

and the ground water claimed was first used for the purposes set out below on 1950
(Date)

since which time the water has been used _____
(Continuously or Intermittently)

from APRIL to OCT.
(Date) (Date)

4. Quantity of water claimed and used is 400 gallons per minute; 100 acre feet per year.

5. Purpose or Purposes for which water is used IRRIG

(Domestic, irrigation, municipal, manufacturing, industrial, etc.)

6. Description of Well: Depth 14 feet. Type DUG
(Dug or drilled)

diameter 33 inches. Elevation of ground at well site, _____ feet, mean sea level.
(As near as known)

Depth to water table 9 1/2 feet.

7. Capacity of Well: _____ g.p.m. with _____ feet drawdown.

_____ g.p.m. with _____ feet drawdown.

Date of test NO TEST


If Flowing Well: Measured discharge _____ g.p.m. on _____
(Date)

Shut-in pressure at ground surface _____ lbs. per sq. in. on _____
(Date)

Water is controlled by _____
(Cap, valve, etc.)

Township 17 S Range 1 W W.M.
North

38 acres

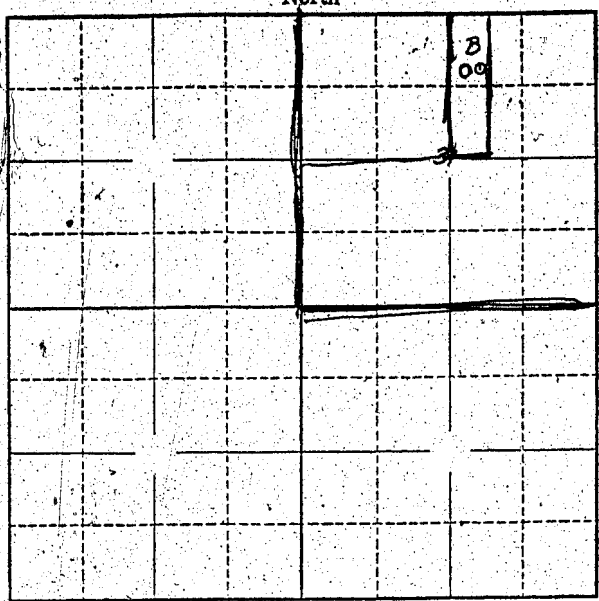

Locate well and acreage of irrigated land on plat.
Scale: 2" = 1 Mile

STATE OF OREGON }
County of Lane } ss.

I, GUY MATHEWS, being first duly sworn, do hereby certify that I have read the foregoing Registration Statement and that all of the items therein contained are true to the best of my knowledge and belief.

Guy Mathews
(Signature of Registrant)

Subscribed and sworn to before me this 10th day of July, 1959

My commission expires _____
(SEAL) NOTARY PUBLIC FOR OREGON
My Commission Expires Jan. 7, 1959
Harold M. [Signature]
(Notary Public)

CERTIFICATE OF REGISTRATION

STATE OF OREGON }
County of Marion } ss.

This is to certify that the foregoing Registration Statement was received in the office of the State Engineer on the 30th day of July, 1959, at 9:00 o'clock A.M. and has been duly recorded in said office in Book No. 17 of Registration Statements on page GR 4049

Witness my hand this 16th day of May, 1960
Lure A. Stanley
(State Engineer)

By _____
(Deputy)

GR 4049

\$16.20