

Registration Statement

OF CLAIMANT OF RIGHT TO APPROPRIATE GROUND WATER

TO THE STATE ENGINEER OF OREGON:

I, Guy E. Jaques

of 1765 S. W. Old River Road Oswego County of Clackamas

(Mailing address)

State of Oregon, do hereby make application for a certificate of registration as evidence of a right to appropriate ground water.

1. Source from which water is withdrawn is pump well
(Flowing well, pump well, infiltration trench, or tunnel)

2. Location is: approximately 2 miles southeast of Oswego, Oregon
(Approximate distance and direction from nearest city or town)

and is more particularly described as follows:

(a) 300 feet east & 350 feet north from W 1/4 corner Section 13
(Give distance and bearing to corner of section or other legal subdivision)

being within (Tax lot 5) SW 1/4 of NW 1/4 of Sec. 13, Twp. 2 south Rge. 1 east
(Smallest legal subdivision) (N. or S.) (E. or W.)

or (b) within limits of recorded platted property, town or city:

in Lot 5, Block _____ of _____
(Name of plat or addition) #

County of _____
(If within city or town, give name)

3. Construction Work was begun on May 1950; was completed on June 1950
(Date) (Date)

and the ground water claimed was first used for the purposes set out below on July 1950
(Date)

since which time the water has been used continuously
(Continuously or intermittently)

from July 1950 to July 29, 1958
(Date) (Date)

4. Quantity of water claimed and used is 15 gallons per minute, 415,000 gallons per year
Gallons per acre

5. Purpose or Purposes for which water is used domestic and watering (lawn and garden)
(Domestic, irrigation, municipal, manufacturing, industrial, etc.)

6. Description of Well: Depth 72 feet, Type drilled
(Dug or drilled)

diameter 6 inches. Elevation of ground at well site 20 feet, mean sea level.
(As near as known)

Depth to water table 10 feet.

7. Capacity of Well: 30 g.p.m. with 25 feet drawdown.

_____ g.p.m. with _____ feet drawdown.

Date of test June 1950

If Flowing Well: Measured discharge _____ g.p.m. on _____
(Date)

Shut-in pressure at ground surface _____ lbs. per sq. in. on _____
(Date)

Water is controlled by _____
(Cap, valve, etc.)


Property can be easily located as 17650 S. W.

Old River Road, Oswego, Oregon

Tax lot 5 Section 14

Township 2 south Range 1 east, W.M.

North

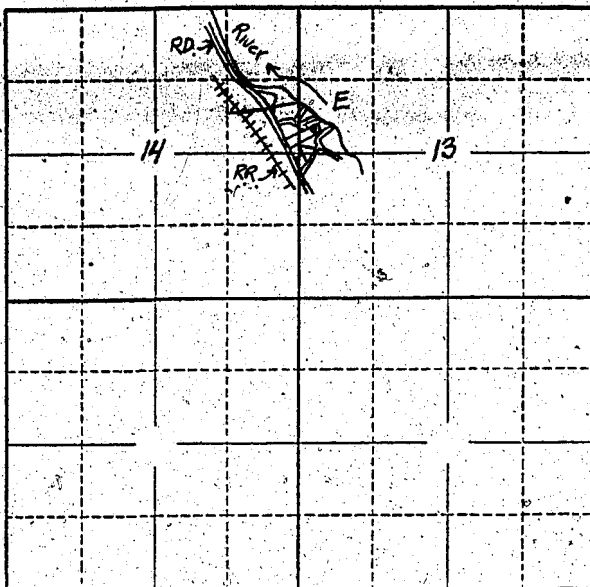

Locate well and acreage of irrigated land on plat.

Scale of 2" = 1 mile
Scale of 1" = 200 ft.

STATE OF OREGON

County of Multnomah

ss.

I, Guy E. Jaques, being first duly sworn, do hereby certify that I have read the foregoing Registration Statement and that all of the items therein contained are true to the best of my knowledge and belief.

Guy E. Jaques
(Signature of Registrant)

Subscribed and sworn to before me this 28th day of July, 1958.

My commission expires August 31, 1958.

Max J. Lachman
(Notary Public)

(SEAL)

CERTIFICATE OF REGISTRATION

STATE OF OREGON

County of Marion

ss.

This is to certify that the foregoing Registration Statement was received in the office of the State Engineer on the 30th day of July, 1958, at 2:00 o'clock A.M. and has been duly recorded in said office in Book No. 16 of Registration Statements on page GR 3892

Witness my hand this 15th day of February, 1960

Lewis A. Stanley
(State Engineer)

By _____ (Deputy)

\$15.00

GR 3892