

RECEIVED  
STATE ENGINEER  
S... ..

Registration No. GR - 3189

Certificate No. GR 4079

# Registration Statement

## OF CLAIMANT OF RIGHT TO APPROPRIATE GROUND WATER

#2 Well

TO THE STATE ENGINEER OF OREGON:

We, Walter L. Wilson and Bernice L. Wilson

of 232 Janney Lane, Medford County of Jackson

State of Oregon do hereby make application for a certificate of registration as evidence of a right to appropriate ground water.

1. Source from which water is withdrawn is pump well # 2  
(Flowing well, pump well, infiltration trench, or tunnel)

2. Location is: two miles from Medford, Oregon  
(Approximate distance and direction from nearest city or town)

and is more particularly described as follows:

(a) #2 Well is located 131' N. 4 5/8' W. from the S.E. Cor. of Lot 12  
~~Part of Lots 18 and 19~~ in Resubdivision of Perry Subdivision in DLC74  
(Give distance and bearing to corner of section or other legal subdivision)

being within SE 1/4 NW 1/4 SE 1/4 of Sec. 27, Twp. 37 So., Rge. 2 W  
(Smallest legal subdivision) (N. or S.) (E. or W.)

or (b) within limits of recorded platted property, town or city:

in Lot 19, Block --- of Re-Subdivision of Perry Subdivision  
(Name of plat or addition)

County of Jackson  
(If within city or town, give name)

3. Construction Work was begun on June, 1953; was completed on 1954  
(Date) (Date)

and the ground water claimed was first used for the purposes set out below on 1954  
(Date)

since which time the water has been used continuously  
(Continuously or Intermittently)

from 1954 date to --- date  
(Date) (Date)

4. Quantity of water claimed and used is 10 gallons per minute; 4.5 acre feet per year.

5. Purpose or Purposes for which water is used irrigation  
(Domestic, irrigation, municipal, manufacturing, industrial, etc.)

6. Description of Well: Depth 15 feet. Type dug  
(Dug or drilled)

diameter 48 inches. Elevation of ground at well site 1600 feet, mean sea level.  
(As near as known)

Depth to water table 3'10" feet.

7. Capacity of Well: 10 g.p.m. with none feet drawdown.  
g.p.m. with --- feet drawdown.

Date of test July 25, 1958

If Flowing Well: Measured discharge --- g.p.m. on ---  
(Date)

Shut-in pressure at ground surface --- lbs. per sq. in. on ---  
(Date)

Water is controlled by ---  
(Cap, valve, etc.)

8. Casing: (Give diameter, commercial specifications and depth below ground surface of each casing size.)

..... inch diameter ..... from ..... to ..... feet
..... inch diameter ..... from ..... to ..... feet
..... inch diameter ..... from ..... to ..... feet
..... inch diameter ..... from ..... to ..... feet

Describe and show depth of shoe, plug, adapter, liner or other details: .....

9. Perforated Casings or Screens:

(Number per foot and size of perforations, or describe screen) from ..... to .....
from ..... to .....
from ..... to .....
from ..... to .....

10. Log of Well: (Describe each stratum or formation clearly, indicate if water bearing, and give thickness and depth as indicated.)

Table with 3 columns: MATERIAL, Thickness (Feet), Depth to Bottom (Feet). The first row contains the handwritten text 'Not Known' under the MATERIAL column.

If log of well is not available, give name and address of driller. Well dug by Claimant's Son

11. Infiltration Trench: Covered or open \_\_\_\_\_

Dimensions: Length \_\_\_\_\_ ft. Minimum depth \_\_\_\_\_ ft. Maximum depth \_\_\_\_\_ ft.

Bottom width \_\_\_\_\_ ft. Discharge \_\_\_\_\_ g.p.m. Date of test \_\_\_\_\_

12. Tunnel: Type of lining \_\_\_\_\_

Dimensions: \_\_\_\_\_  
(Length, course, and cross sectional size)

Position of water bearing stratum with reference to portal of tunnel \_\_\_\_\_

Log of tunnel: (Preceding table for log of well may be used, if desired. Give footage from portal and character of materials, as pertinent.)

13. Pumping Equipment:

(a) Pump Centrifugal 1" intake 3/4" discharge Capacity 10 g.p.m.  
(Make, type and size)

(b) Motor Electric 1/3 H.P.  
(Type and horsepower)

14. Location of area irrigated or to be irrigated, or place of use if for purposes other than irrigation.


Township North or South	Range E. or W. of Willamette Meridian	Section	Forty-acre Tract	Number Acres To Be Irrigated	Date of Reclamation
<del>37 S</del>	<del>2 W</del>	<del>27</del>	<del>Part lots 18 &amp; 19 in Resubdiv. of Perry Subdiv.</del>	<del>1.00 ac</del>	
<del>T 37 S</del>	<del>R 2 W</del>	<del>27</del>	<del>Part lots 18, 19, &amp; 20 SE 1/4 NW 1/4 SE 1/4</del>	<del>1.00 ac</del>	<del>1954</del>
T 37 S	R 2 W	27	Part lots 18, 19, & 20 SE 1/4 NW 1/4 SE 1/4	0.91 ac	1954
T 37 S	R 2 W	27	lot 20 NE 1/4 SW 1/4 SE 1/4	0.09 ac	1954
			Total	1.00 ac	

15. If the ground water supply is supplemental to an existing water supply, identification of any application for a permit, permit, certificate or adjudicated right to appropriate water made or held by the registrant.

None

170 of  
old Perry Subdivision

Township 37 S Range 2 W W.M.  
North

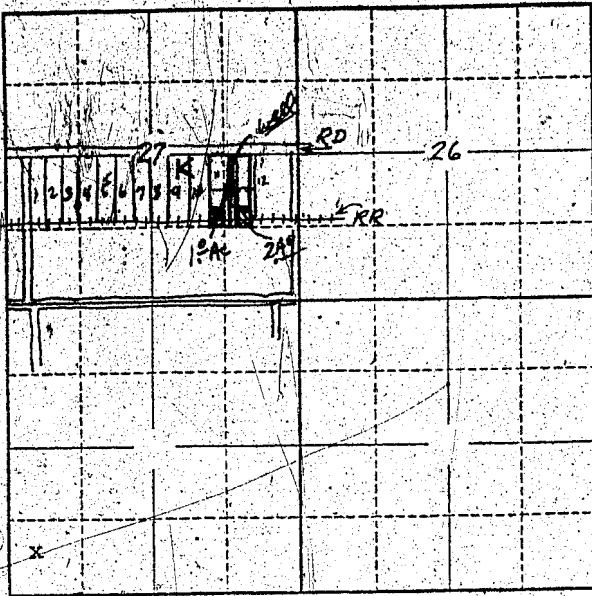

~~321-18~~ Locate well and acreage of irrigated land on plat.  
Scale: 2" = 1 Mile

STATE OF OREGON }  
County of Jackson } ss.

I, Walter L. Wilson, being first duly sworn, do hereby certify that I have read the foregoing Registration Statement and that all of the items therein contained are true to the best of my knowledge and belief.

Walter L. Wilson  
(Signature of Registrant)

Subscribed and sworn to before me this 28 day of July, 1958

My commission expires Sept. 24, 1958

[Signature]  
(Notary Public)

(SEAL)

**CERTIFICATE OF REGISTRATION**

STATE OF OREGON }  
County of Marion } ss.

This is to certify that the foregoing Registration Statement was received in the office of the State Engineer on the 30th day of July, 1958, at 8:00 o'clock A. M. and has been duly recorded in said office in Book No. 17 of Registration Statements on page 4079

Witness my hand this 16th day of May, 1960

LEWIS A. STANLEY  
(State Engineer)

By Max F. Rogers  
(Deputy)

\$15.00

GR. 4079