

# Registration Statement

## OF CLAIMANT OF RIGHT TO APPROPRIATE GROUND WATER

RECEIVED  
JAN 21 1950  
STATE ENGINEER  
SALEM, OREGON

TO THE STATE ENGINEER OF OREGON:

I, Willard J. & Gladys L. Swenson

of Route 1, Box 74 Eugene, Oregon County of Lane

State of Oregon do hereby make application for a certificate of registration as evidence of a right to appropriate ground water.

1. Source from which water is withdrawn is Dump well

(Flowing well, pump well, infiltration trench, or tunnel)

2. Location is: Eugene, six miles north west

(Approximate distance and direction from nearest city or town)

and is more particularly described as follows: 850 feet west & 200 feet North from SE Corner Section 3

(a) SE Corner Marion Tract, N.L.C. # 56

(Give distance and bearing to corner of section or other legal subdivision)

being within Tax Lot 26 Cont. 5.00 Acres Sec. 3, Twp. 17S, Rge. 24E

(Smallest legal subdivision)

(N. or S.)

(E. or W.)

or (b) within limits of recorded-platted property, town or city:

in Lot \_\_\_\_\_ Block \_\_\_\_\_ of \_\_\_\_\_

(Name of plat or addition)

County of \_\_\_\_\_

(If within city or town, give name)

Construction Work was begun on May 1948; was completed on May 1948

(Date)

(Date)

and the ground water claimed was first used for the purposes set out below on May 1948

(Date)

since which time the water has been used Continuously

(Continuously or intermittently)

from May to October

(Date)

(Date)

4. Quantity of water claimed and used is: 100 gallons per minute; 2 acre feet per year.

5. Purpose or Purposes for which water is used

irrigation

(Domestic, irrigation, municipal, manufacturing, industrial, etc.)

6. Description of Well: Depth 20 feet. Type Drove

(Dug or drilled)

diameter 3 inches. Elevation of ground at well site 380 feet, mean sea level.

(As near as known)

Depth to water table 15 feet.

7. Capacity of Well: \_\_\_\_\_ g.p.m. with \_\_\_\_\_ feet drawdown.

\_\_\_\_\_ g.p.m. with \_\_\_\_\_ feet drawdown.

Date of test Not tested

If Flowing Well: Measured discharge \_\_\_\_\_ g.p.m. on \_\_\_\_\_

(Date)

Shut-in pressure at ground surface \_\_\_\_\_ lbs. per sq. in. on \_\_\_\_\_

(Date)

Water is controlled by \_\_\_\_\_

(Cap, valve, etc.)

8. **Casing:** (Give diameter, commercial specifications and depth below ground surface of each casing size.)

3 inch diameter ..... from 0 to 20 feet  
..... inch diameter ..... from ..... to ..... feet  
..... inch diameter ..... from ..... to ..... feet  
..... inch diameter ..... from ..... to ..... feet

Describe and show depth of shoe, plug, adapter, liner or other details: .....

9. **Perforated Casings or Screens:**

slotted ..... from 17 to 20  
(Number per foot and size of perforations, or describe screen)  
..... from ..... to .....  
..... from ..... to .....  
..... from ..... to .....

10. **Log of Well:** (Describe each stratum or formation clearly, indicate if water bearing, and give thickness and depth as indicated.)

MATERIAL	Thickness (Feet)	Depth to Bottom (Feet)
none		

If log of well is not available, give name and address of driller. Milner-Jensen Co., 2800

Elmira Rd., Eugene, Oregon

11. Infiltration Trench: Covered or open \_\_\_\_\_

Dimensions: Length \_\_\_\_\_ ft. Minimum depth \_\_\_\_\_ ft. Maximum depth \_\_\_\_\_ ft.

Bottom width \_\_\_\_\_ ft. Discharge \_\_\_\_\_ g.p.m. Date of test \_\_\_\_\_

12. Tunnel: Type of lining \_\_\_\_\_

Dimensions: \_\_\_\_\_  
(Length, course, and cross sectional size)

Position of water bearing stratum with reference to portal of tunnel \_\_\_\_\_

Log of tunnel: (Preceding table for log of well may be used, if desired: Give footage from portal and character of materials, as pertinent.)

13. Pumping Equipment:

(a) Pump Ingersoll-Rand TYPE 1 1/2 RYN-3 Capacity 100 g.p.m.  
(Make, type and size)


(b) Motor General Electric Single phase 3 hp.  
(Type and horsepower)

14. Location of area irrigated or to be irrigated, or place of use if for purposes other than irrigation.

Township North or South	Range E. or W. of Willamette Meridian	Section	Forty-acre Tract	Number Acres To Be Irrigated	Date of Reclamation
<u>T17 S</u>	<u>R4W</u>	<u>3</u>	<u>SE 1/4 of SE 1/4</u>	<u>(5 acres) 3 1/2</u>	<u>May 1949</u>
<u>"</u>	<u>"</u>	<u>"</u>	<u>NE 1/4 of SE 1/4</u>	<u>1 1/2</u>	<u>" "</u>
				<u>Total 5.0</u>	<u>" "</u>

15. If the ground water supply is supplemental to an existing water supply, identification of any application for permit, permit, certificate or adjudicated right to appropriate water made or held by the registrant.

Township 17S Range R4W W.M.  
North

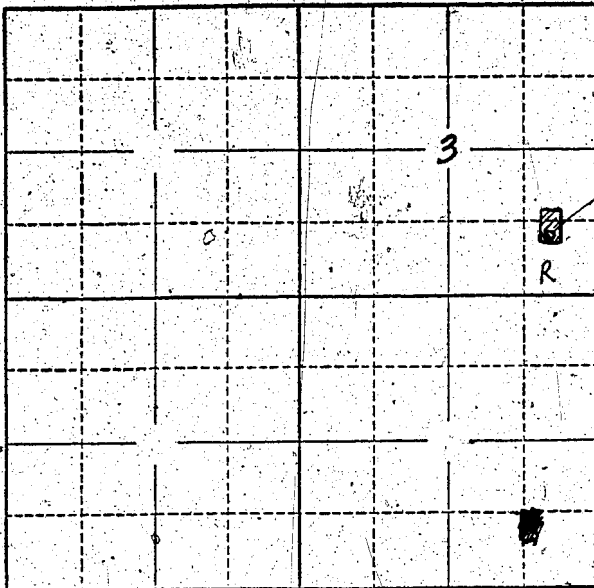

Locate well and acreage of irrigated land on plat.  
Scale: 2" = 1 Mile

STATE OF OREGON

County of Lane } ss.

I, Willard J. Swenson, being first duly sworn, do hereby certify that I have read the foregoing Registration Statement and that all of the items therein contained are true, to the best of my knowledge and belief.

Willard J. Swenson  
(Signature of Registrant)

Subscribed and sworn to before me this 28th day of July, 1958

My commission expires 9-29-60

D. G. Young  
(Notary Public)

(SEAL)

**CERTIFICATE OF REGISTRATION**

STATE OF OREGON

County of Marion } ss.

This is to certify that the foregoing Registration Statement was received in the office of the State Engineer on the 30 day of July, 1958, at 5:00 o'clock A.M. and has been duly recorded in said office in Book No. 16 of Registration Statements on page GR 3928

Witness my hand this 15th day of February, 1960

Leura A. Stanley  
(State Engineer)

\$15.00

By \_\_\_\_\_ (Deputy)

GR 3928