

Well

Registration No. GR - 3197

Certificate No. GR - 2974

# Registration Statement

## OF CLAIMANT OF RIGHT TO APPROPRIATE GROUND WATER

TO THE STATE ENGINEER OF OREGON:

1. Stayton Canning Company Cooperative  
of Stayton Oregon County of Marion  
(Mailing address)

State of Oregon, do hereby make application for a certificate of registration as evidence of a right to appropriate ground water.

1. Source from which water is withdrawn is Pump Well  
(Flowing well, pump well, infiltration trench, or tunnel)

2. Location is: West side of Stayton Oregon  
(Approximate distance and direction from nearest city or town)

and is more particularly described as follows:

(a) 1821 feet North + 742' East of SW Cor of Sec 10  
(Give distance and bearing to corner of section or other legal subdivision)  
being within NW 1/4 of SW 1/4 of Sec. 10, Twp. 9S, Rge. 1W  
(Smallest legal subdivision) (N. or S.) (E. or W.)

or (b) within limits of recorded platted property, town or city:

in Lot \_\_\_\_\_, Block \_\_\_\_\_ of \_\_\_\_\_  
(Name of plat or addition)

County of \_\_\_\_\_  
(If within city or town, give name)

3. Construction Work was begun on 1 May 1937, was completed on 1 June 1937  
(Date) (Date)

and the ground water claimed was first used for the purposes set out below on 1 June 1937  
(Date)

since which time the water has been used Continuously  
(Continuously or intermittently)

from 1 June 1937 to Date  
(Date) (Date)

4. Quantity of water claimed and used is 150 GPM gallons per minute; \_\_\_\_\_ acre feet per year.

5. Purpose or Purposes for which water is used Industrial  
(Domestic, irrigation, municipal, manufacturing, industrial, etc.)

6. Description of Well: Depth 96' feet. Type Drilled  
(Dug or drilled)

diameter 10 inches. Elevation of ground at well site 300' feet, mean sea level.  
(As near as known)

Depth to water table \_\_\_\_\_ feet.

7. Capacity of Well: 150 g.p.m. with 0 feet drawdown.

\_\_\_\_\_ g.p.m. with \_\_\_\_\_ feet drawdown.

Date of test June 1937

If Flowing Well: Measured discharge \_\_\_\_\_ g.p.m. on \_\_\_\_\_  
(Date)


Shut-in pressure at ground surface \_\_\_\_\_ lbs. per sq. in. on \_\_\_\_\_  
(Date)

Water is controlled by \_\_\_\_\_  
(Cap, valve, etc.)





Township 9S Range 1W W.M.  
North

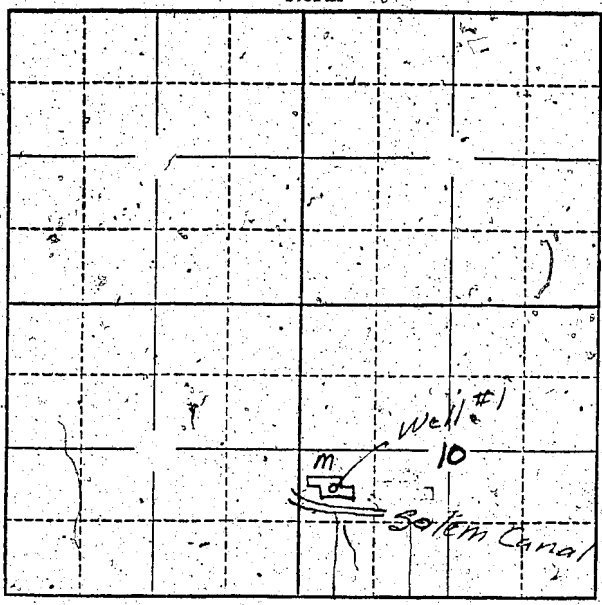

Locate well and acreage of irrigated land on plat.  
Scale: 2" = 1 Mile

STATE OF OREGON

County of Marion } ss.

I, F. M. SMITH, being first duly sworn, do hereby certify that I have read the foregoing Registration Statement and that all of the items therein contained are true to the best of my knowledge and belief.

F. M. Smith  
(Signature of Registrant)

Subscribed and sworn to before me this 28th day of July, 1958.

My commission expires My Commission Expires May 26, 1959

L. Bate  
(Notary Public)

(SEAL)

**CERTIFICATE OF REGISTRATION**

STATE OF OREGON

County of Marion } ss.

This is to certify that the foregoing Registration Statement was received in the office of the State Engineer on the 30 day of July, 1958, at 8:00 o'clock A. M. and has been duly recorded in said office in Book No. 13 of Registration Statements on page GR 2974

Witness my hand this 2nd day of June

1959  
Clara A. Stanley  
(State Engineer)

\$ 20.00

By \_\_\_\_\_  
(Deputy)

GR - 2974