

Well # 2
47200

Registration No. GR - 3198

Certificate No. GR - 2975

Registration Statement

OF CLAIMANT OF RIGHT TO APPROPRIATE GROUND WATER

TO THE STATE ENGINEER OF OREGON:

I, Stayton Canning Company Cooperative
of Stayton County of Marion

State of Oregon do hereby make application for a certificate of registration as evidence of a right to appropriate ground water.

1. Source from which water is withdrawn is Pump Well
(Flowing well, pump well, infiltration trench, or tunnel)

2. Location is: West side of Stayton Oregon
(Approximate distance and direction from nearest city or town)

and is more particularly described as follows:

(a) 1679 feet North 683 feet E of S.W. cor Sec 10
(Give distance and bearing to corner of section or other legal subdivision)

being within NW 1/4 of SW 1/4 of Sec. 10, Twp. 2 S, Rge. 1 W
(Smallest legal subdivision) (N. or S.) (E. or W.)

or (b) within limits of recorded platted property, town or city:

in Lot _____, Block _____ of _____
(Name of plat or addition)

County of _____
(If within city or town, give name)

3. Construction Work was begun on March 1945; was completed on May 1945
(Date) (Date)

and the ground water claimed was first used for the purposes set out below on _____
(Date)

since which time the water has been used _____
(Continuously or intermittently)

from May 1945 to present date
(Date) (Date)

4. Quantity of water claimed and used is 4000 gallons per minute; _____ acre feet per year.

5. Purpose or Purposes for which water is used _____

Industrial
(Domestic, irrigation, municipal, manufacturing, industrial, etc.)

6. Description of Well: Depth 120 feet. Type Drilled
(Dug or drilled)

diameter 12 inches. Elevation of ground at well site 300' feet, mean sea level.
(As near as known)

Depth to water table _____ feet.

7. Capacity of Well: 250 g.p.m. with No feet drawdown.

_____ g.p.m. with _____ feet drawdown.


Date of test May 1945

If Flowing Well: Measured discharge _____ g.p.m. on _____
(Date)

Shut-in pressure at ground surface _____ lbs. per sq. in. on _____
(Date)

Water is controlled by _____
(Cap, valve, etc.)

Township 9S Range 1W W.M.
North

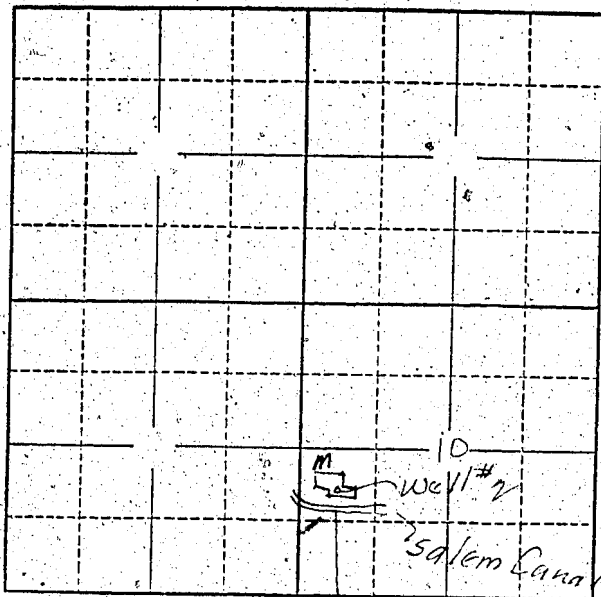

Locate well and acreage of irrigated land on plat.
Scale: 2" = 1 Mile

STATE OF OREGON

County of Marion } ss.

I, J. M. Smith, being first duly sworn, do hereby certify that I have read the foregoing Registration Statement and that all of the items therein contained are true to the best of my knowledge and belief.

J. M. Smith
(Signature of Registrant)

Subscribed and sworn to before me this 28th day of July, 1958

My commission expires My Commission Expires May 20, 1963

A. Bates
(Notary Public)

(SEAL)

CERTIFICATE OF REGISTRATION

STATE OF OREGON

County of Marion } ss.

This is to certify that the foregoing Registration Statement was received in the office of the State Engineer on the 30 day of July, 1958, at 8:00 o'clock A. M. and has been duly recorded in said office in Book No. 13 of Registration Statements on page GR-2975

Witness my hand this 2nd day of June, 1959

Lewis A. Stanley
(State Engineer)

\$ 20.00

By _____
(Deputy)

GR-2975