

**Registration Statement****OF CLAIMANT OF RIGHT TO APPROPRIATE GROUND WATER**

(Under Chapter 708, Oregon Laws 1955.)

**TO THE STATE ENGINEER OF OREGON:**I, Emil Ballaof 365 South Lancaster Dr. County of MarionState of OREGON do hereby make application for a certificate of registration as evidence of a right to appropriate ground water.1. Source from which water is withdrawn is Pump Well  
(Flowing well, pump well, infiltration trench, or tunnel)2. Location is: 2 mile east and 1 mile south of Salem  
(Approximate distance and direction from nearest city or town)

and is more particularly described as follows:

(a) 1250 feet east and 810 feet south from NW 1/4 corner section 31  
250 feet west of Lancaster Dr.

(Give distance and bearing to corner of section or other legal subdivision)

being within 4 corners of Sec. 31, Twp. 7 S, Rge. 2 W  
(Smallest legal subdivision) (N. or S.) (E. or W.)or (b) within limits of recorded platted property, town or city: Salemin Lot \_\_\_\_\_, Block \_\_\_\_\_ of \_\_\_\_\_  
(Name of plat or addition)County of Marion  
(If within city or town, give name)3. Construction Work was begun on Jan. 25, 1955, was completed on Feb. 2, 1955  
(Date) (Date)and the ground water claimed was first used for the purposes set out below on June 1, 1955  
(Date)since which time the water has been used intermittently  
(Continuously or intermittently)from 6/1/55 to 8/21/56  
(Date) (Date)4. Quantity of water claimed and used is 170 gallons per minute; 15 acre feet per year.5. Purpose or Purposes for which water is used Irrigating Green Beans

(Domestic, irrigation, municipal, manufacturing, industrial, etc.)

6. Description of Well: Depth 93 feet. Type Drilled  
(Dug or drilled)diameter 8 inches. Elevation of ground at well site 220 feet, mean sea level.  
(As near as known)Depth to water table 8.10 feet.7. Capacity of Well: 1700 g.p.m. with 50 feet drawdown.


g.p.m. with \_\_\_\_\_ feet drawdown.

Date of test Feb. 9, 1955If Flowing Well: Measured discharge \_\_\_\_\_ g.p.m. on \_\_\_\_\_  
(Date)Shut-in pressure at ground surface \_\_\_\_\_ lbs. per sq. in. on \_\_\_\_\_  
(Date)Water is controlled by \_\_\_\_\_  
(Cap, valve, etc.)





Township 7 S Range 2 W, W.M.  
North

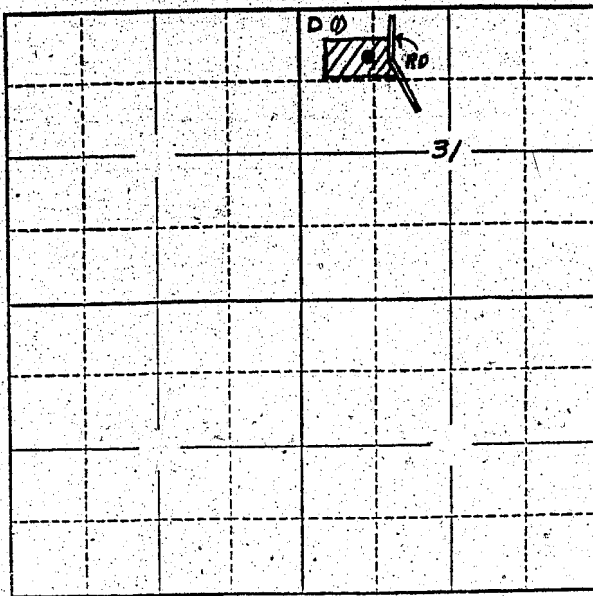

Locate well and acreage of irrigated land on plat.  
Scale: 2" = 1 Mile

STATE OF OREGON

County of Marion } ss.

I, Emil Balla, being first duly sworn, do hereby certify that I have read the foregoing Registration Statement and that all of the items therein contained are true to the best of my knowledge and belief.

*Emil Balla*  
(Signature of Registrant)

Subscribed and sworn to before me this 16 day of October, 1956

My commission expires April 26, 1960

*Leslie J. Lane*  
(Notary Public)

(SEAL)

**CERTIFICATE OF REGISTRATION**

STATE OF OREGON

County of Marion } ss.

This is to certify that the foregoing Registration Statement was received in the office of the State Engineer on the 26th day of December, 1956, at 10 o'clock A. M. and has been duly recorded in said office in Book No. 2 of Registration Statements on page GR-302-C

~~Construction shall be completed by X-X-X-X-X-X-X-X-X-X-X-X-X-X and the water completely applied to beneficial use by X-X-X-X-X-X-X-X-X-X-X-X-X-X~~

Witness my hand this 25th day of February, 1957

*Lewis A. Stanley*  
(State Engineer)

By \_\_\_\_\_ (Deputy)

#1500

GR-302C