

Well #4

Registration No. GR - 3200

Certificate No. GR 2977

Registration Statement

OF CLAIMANT OF RIGHT TO APPROPRIATE GROUND WATER

TO THE STATE ENGINEER OF OREGON:

I, Stayton Canning Company Cooperative
of Stayton (Mailing address) County of Marion

State of Oregon do hereby make application for a certificate of registration as evidence of a right to appropriate ground water.

1. Source from which water is withdrawn is Pump Well #4
(Flowing well, pump well, infiltration trench, or tunnel)

2. Location is: West side of Stayton Oregon
(Approximate distance and direction from nearest city or town)

and is more particularly described as follows:

(a) ~~1350~~ ⁶¹³ North - 613 feet East of SW Cor of Sec 10
(Give distance and bearing to corner of section or other legal subdivision)

being within NW 1/4 of SW 1/4 of Sec. 10, Twp. 9 S Rge. 1 W
(Smallest legal subdivision) (N. or S.) (E. or W.)

or (b) within limits of recorded platted property, town or city:

in Lot _____, Block _____ of _____
(Name of plat or addition)

County of _____
(If within city or town, give name)

3. Construction Work was begun on 1 Nov 1953, was completed on Jan 1, 1954
(Date) (Date)

and the ground water claimed was first used for the purposes set out below on 1 Jan 1954
(Date)

since which time the water has been used: Continuously
(Continuously or Intermittently)

from 1 Jan 1954 to Present date
(Date) (Date)

4. Quantity of water claimed and used is 450 gallons per minute; _____ acre feet per year.

5. Purpose or Purposes for which water is used Industrial

(Domestic, irrigation, municipal, manufacturing, industrial, etc.)

6. Description of Well: Depth 48.5 feet. Type Drilled
(Dug or drilled)

diameter 12 inches. Elevation of ground at well site 300 feet, mean sea level.
(As near as known)

Depth to water table unk feet.

7. Capacity of Well: 450 g.p.m. with 100 feet drawdown.

_____ g.p.m. with _____ feet drawdown.


Date of test 1 Jan 1954

If Flowing Well: Measured discharge _____ g.p.m. on _____
(Date)

Shut-in pressure at ground surface _____ lbs. per sq. in. on _____
(Date)

Water is controlled by _____
(Cap, valve, etc.)

Township 95 Range 10 W.M.
North

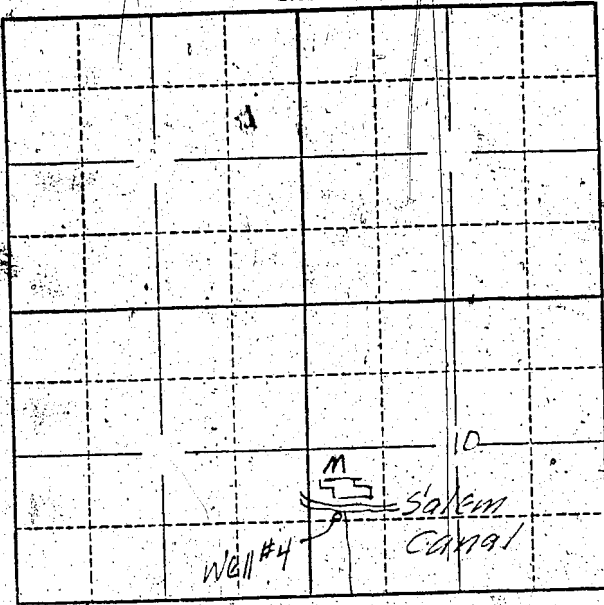

Locate well and acreage of irrigated land on plat.
Scale: 2" = 1 Mile

STATE OF OREGON }
County of Marion } ss.

I, F. M. Smith, being first duly sworn, do hereby certify that I have read the foregoing Registration Statement and that all of the items therein contained are true to the best of my knowledge and belief.

F. M. Smith
(Signature of Registrant)

Subscribed and sworn to before me this 28th day of July, 1958

My commission expires May 28 1959

S. Bate
(Notary Public)

(SEAL)

CERTIFICATE OF REGISTRATION

STATE OF OREGON }
County of Marion } ss.

This is to certify that the foregoing Registration Statement was received in the office of the State Engineer on the 30th day of July, 1958, at 8:00 o'clock A. M. and has been duly recorded in said office in Book No. 13 of Registration Statements on page GR 2977

Witness my hand this 2nd day of June, 1959

LeWia A. Stanley
(State Engineer)

By _____
(Deputy)

GR - 2977

22.00