

Registration No. GR - 3201

Certificate No. GR 2978

# Registration Statement

## OF CLAIMANT OF RIGHT TO APPROPRIATE GROUND WATER

TO THE STATE ENGINEER OF OREGON:

I, C. L. MARTINAK

of Rt. 1, Box 297, ALBANY County of LYNN

State of OREGON, do hereby make application for a certificate of registration as evidence of a right to appropriate ground water.

1. Source from which water is withdrawn is PUMP WELL  
(Flowing well, pump well, infiltration trench, or tunnel)

2. Location is: 2 MILES W OF CRABTREE, ORE.  
(Approximate distance and direction from nearest city or town)

and is more particularly described as follows:

(a) 1220'S AND 442' W OF NE CORNER S. 9. T. 11S, R. 2W  
(Give distance and bearing to corner of section or other legal subdivision)

being within NE 1/4 OF NE 1/4 of Sec. 9, Twp. 11S, Rge. 2W.  
(Smallest legal subdivision) (N. or S.) (E. or W.)

or (b) within limits of recorded platted property, town or city:

in Lot \_\_\_\_\_, Block \_\_\_\_\_ of \_\_\_\_\_  
(Name of plat or addition)

County of LYNN  
(If within city or town, give name)

3. Construction Work was begun on 1951; was completed on 1951  
(Date) (Date)

and the ground water claimed was first used for the purposes set out below on MAY 1951  
(Date)

since which time the water has been used CONTINUOUSLY  
(Continuously or intermittently)

from MAY 1951 to PRESENT TIME  
(Date) (Date)

4. Quantity of water claimed and used is 112 gallons per minute; 30.0 acre feet per year.

5. Purpose or Purposes for which water is used IRRIGATION

(Domestic, irrigation, municipal, manufacturing, industrial, etc.)

6. Description of Well: Depth 21 feet. Type DRIVEN  
(Dug or drilled)

diameter 3 inches. Elevation of ground at well site 260 feet, mean sea level.  
(As near as known)

Depth to water table 12 feet.

7. Capacity of Well: \_\_\_\_\_ g.p.m. with \_\_\_\_\_ feet drawdown.

\_\_\_\_\_ g.p.m. with \_\_\_\_\_ feet drawdown.

Date of test N.O.T. TESTED

If Flowing Well: Measured discharge \_\_\_\_\_ g.p.m. on \_\_\_\_\_  
(Date)

Shut-in pressure at ground surface \_\_\_\_\_ lbs. per sq. in. on \_\_\_\_\_  
(Date)

Water is controlled by \_\_\_\_\_  
(Cap, valve, etc.)

8. Casing: (Give diameter, commercial specifications and depth below ground surface of each casing size.)

3 inch diameter BOILER TUBING from 0 to 21 feet  
 inch diameter from to feet  
 inch diameter from to feet  
 inch diameter from to feet

Describe and show depth of shoe, plug, adapter, liner or other details: \_\_\_\_\_

9. Perforated Casings or Screens:

END OF PIPE PERFORATED from to  
(Number per foot and size of perforations, or describe screen)  
 from to  
 from to  
 from to

10. Log of Well: (Describe each stratum or formation clearly, indicate if water bearing, and give thickness and depth as indicated.)

MATERIAL	Thickness (Feet)	Depth to Bottom (Feet)
NOT AVAILABLE		

If log of well is not available, give name and address of driller. C. J. MARTINAK, RT. 1,

Box 224, ALBANY, ORE.

11. Infiltration Trench: Covered or open .....

Dimensions: Length ..... ft. Minimum depth ..... ft. Maximum depth ..... ft.

Bottom width ..... ft. Discharge ..... g.p.m. Date of test .....

12. Tunnel: Type of lining .....

Dimensions: .....  
(Length, course, and cross sectional size)

Position of water bearing stratum with reference to portal of tunnel .....

Log of tunnel: (Preceding table for log of well may be used; if desired. Give footage from portal and character of materials, as pertinent.)

13. Pumping Equipment:

(a) Pump DEMMING 1 1/2" CENT. Capacity 150 g.p.m.  
(Make, type and size)


(b) Motor S.H.P. ELECTRIC  
(Type and horsepower)

14. Location of area irrigated or to be irrigated, or place of use if for purposes other than irrigation.

Township North or South	Range E. or W. of Willamette Meridian	Section	Forty-acre Tract	Number Acres To Be Irrigated	Date of Reclamation
11S	2W	9	NE 1/4 OF NE 1/4	2.50	MAY 1951
11S	2W	9	SE 1/4 OF NE 1/4	5.25	" "
11S	2W	10	NW 1/4 OF NW 1/4	0.25	" "
11S	2W	10	SW 1/4 OF NW 1/4	2.00	" "
				10.00	

15. If the ground water supply is supplemental to an existing water supply, identification of any application for a permit, permit, certificate or adjudicated right to appropriate water made or held by the registrant.

Township 11 S Range 2 W, W.M.  
North

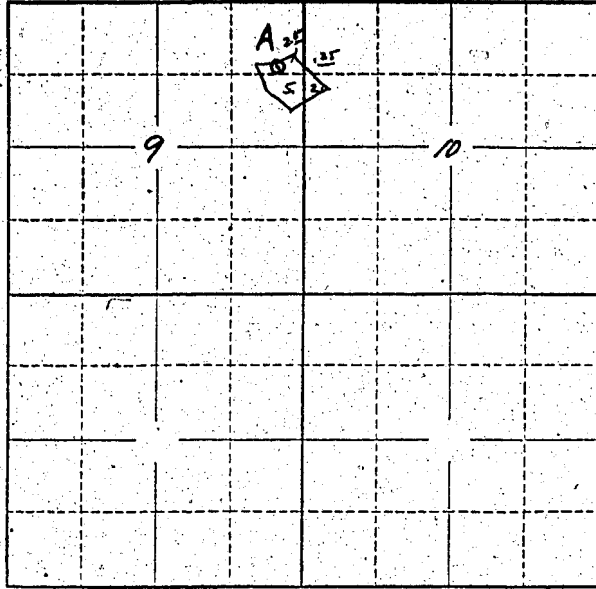

Locate well and acreage of irrigated land on plat.  
Scale: 2" = 1 Mile

STATE OF OREGON }  
County of FINN } ss.

I, C. L. MARTINAK, being first duly sworn, do hereby certify that I have read the foregoing Registration Statement and that all of the items therein contained are true to the best of my knowledge and belief.

C. L. Martinak  
(Signature of Registrant)

Subscribed and sworn to before me this \_\_\_\_\_ day of \_\_\_\_\_, 19\_\_\_\_

My commission expires MY COMMISSION EXPIRES MAY 22, 1962 \_\_\_\_\_  
(Notary Public)

(SEAL)

**CERTIFICATE OF REGISTRATION**

STATE OF OREGON }  
County of Marion } ss.

This is to certify that the foregoing Registration Statement was received in the office of the State Engineer on the 30th day of July, 1952, at 2:00 o'clock A. M. and has been duly recorded in said office in Book No. 13 of Registration Statements on page GR-2978

Witness my hand this 2nd day of June, 1959

Lewis A. Stanley  
(State Engineer)

By \_\_\_\_\_  
(Deputy)

\* 15.00