

RECEIVED
JUL 30 1958
STATE ENGINEER
SALEM, OREGON

Registration Statement

OF CLAIMANT OF RIGHT TO APPROPRIATE GROUND WATER

TO THE STATE ENGINEER OF OREGON:

I, WEBBER DOUGHTON

of Rt. 1, Box 321, Albany County of LINN

State of OREGON, do hereby make application for a certificate of registration as evidence of a right to appropriate ground water.

1. Source from which water is withdrawn is PUMP WELL NO. 2
(Flowing well, pump well, infiltration trench, or tunnel)

2. Location is: 5 1/2 MILES NORTH OF ALBANY, OREGON
(Approximate distance and direction from nearest city or town)

and is more particularly described as follows:

(a) 2838' S AND 1254' W OF NE CORNER S. 11 T. 11 S. R. 20 W
(Give distance and bearing to corner of section or other legal subdivision)

being within N.E. 1/4 OF S.E. 1/4 of Sec. 16, Twp. 11 S, Rge. 20
(Smallest legal subdivision) (N. or S.) (E. or W.)

or (b) within limits of recorded platted property, town or city:

in Lot _____, Block _____ of _____
(Name of plat or addition)

County of LINN
(If within city or town, give name)

3. Construction Work was begun on 1954; was completed on 1954
(Date) (Date)

and the ground water claimed was first used for the purposes set out below on 1954
(Date)

since which time the water has been used CONTINUOUSLY
(Continuously or intermittently)

from 1954 to PRESENT TIME
(Date) (Date)

4. Quantity of water claimed and used is 300 gallons per minute; 900 acre feet per year.

5. Purpose or Purposes for which water is used IRRIGATION

(Domestic, irrigation, municipal, manufacturing, industrial, etc.)

6. Description of Well: Depth 35 feet. Type DRILLED
(Dug or drilled)

diameter 8 inches. Elevation of ground at well site 290 feet, mean sea level.
(As near as known)

Depth to water table 12 feet.

7. Capacity of Well: 300 g.p.m. with 13 feet drawdown.

_____ g.p.m. with _____ feet drawdown.

Date of test 1954

If Flowing Well: Measured discharge _____ g.p.m. on _____
(Date)

Shut-in pressure at ground surface _____ lbs. per sq. in. on _____
(Date)

Water is controlled by _____
(Cap, valve, etc.)

8. Casing: (Give diameter, commercial specifications and depth below ground surface of, each casing size.)

2 inch diameter STEEL CASING from 0 to 35 feet
 _____ inch diameter _____ from _____ to _____ feet
 _____ inch diameter _____ from _____ to _____ feet
 _____ inch diameter _____ from _____ to _____ feet

Describe and show depth of shoe, plug, adapter, liner or other details: _____

9. Perforated Casings or Screens:

SLOT PERFORATIONS from 32 to 35
 (Number per foot and size of perforations, or describe screen)
 _____ from _____ to _____
 _____ from _____ to _____
 _____ from _____ to _____

10. Log of Well: (Describe each stratum or formation clearly, indicate if water bearing, and give thickness and depth as indicated.)

MATERIAL	Thickness (Feet)	Depth to Bottom (Feet)
Not Available		

If log of well is not available, give name and address of driller. BILL HAMILTON DRILLING
Co., 838 E THIRD AVE., ALBANY, ORE.

11. Infiltration Trench: Covered or open

Dimensions: Length ft. Minimum depth ft. Maximum depth ft.

Bottom width ft. Discharge g.p.m. Date of test

12. Tunnel: Type of lining

Dimensions:
(Length, course, and cross sectional size)

Position of water bearing stratum with reference to portal of tunnel

Log of tunnel: (Preceding table for log of well may be used, if desired. Give footage from portal and character of materials, as pertinent.)

13. Pumping Equipment:

(a) Pump COULD 3⁴ CENTRIFUGAL Capacity 50.0 g.p.m.
(Make, type and size)


(b) Motor 20 H.P. ELECTRIC
(Type and horsepower)

14. Location of area irrigated or to be irrigated, or place of use if for purposes other than irrigation.

Township North or South	Range E. or W. of Willamette Meridian	Section	Forty-acre Tract	Number Acres To Be Irrigated	Date of Reclamation
11S.	2W	11	SE ¹ / ₄ OF NE ¹ / ₄	15.0	1954
11S	2W	16	NW ¹ / ₄ OF SE ¹ / ₄	1.0	
11S	2W	16	NE ¹ / ₄ OF SE ¹ / ₄	14.0	
				30.0	

15. If the ground water supply is supplemental to an existing water supply, identification of any application for a permit, permit, certificate or adjudicated right to appropriate water made or held by the registrant.

Township 11S Range 2W, W.M.
North

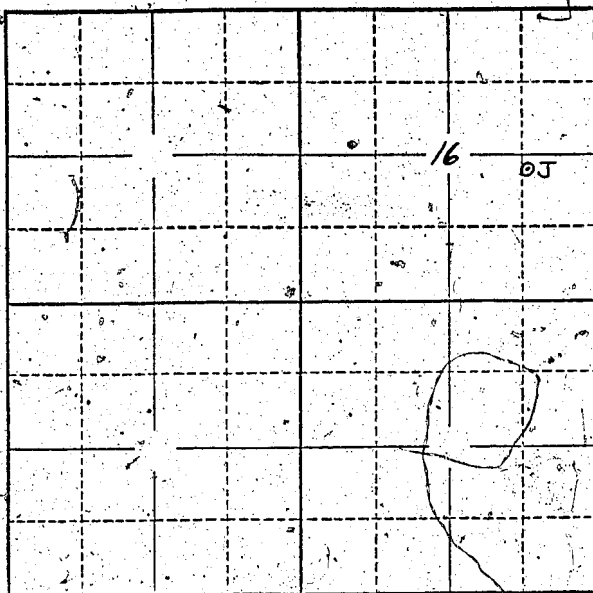

Locate well and acreage of irrigated land on plat.

Scale: 2" = 1 Mile

STATE OF OREGON

County of LINN

ss.

I, WEBBER DOUGLASS, being first duly sworn, do hereby certify that I have read the foregoing Registration Statement and that all of the items therein contained are true to the best of my knowledge and belief.

Webber Douglas
(Signature of Registrant)

Subscribed and sworn to before me this 29 day of July, 1958

My commission expires MY COMMISSION EXPIRES MAY 22, 1962

Henry E. Phillips
(Notary Public)

(SEAL)

CERTIFICATE OF REGISTRATION

STATE OF OREGON

County of Marion

ss.

This is to certify that the foregoing Registration Statement was received in the office of the State Engineer on the 30 day of July, 1958, at 5:00 o'clock A.M. and has been duly recorded in said office in Book No. 13 of Registration Statements on page GR-2989

Witness my hand this 2nd day of June, 1959

Lewis A. Stanley
(State Engineer)

By _____
(Deputy)

GR - 2989

#15.00