

RECEIVED  
JUL 30 1958  
STATE ENGINEER  
SALEM, OREGON

Registration No. GR - 3213  
Certificate No. GR - 2990

# Registration Statement

## OF CLAIMANT OF RIGHT TO APPROPRIATE GROUND WATER

TO THE STATE ENGINEER OF OREGON:

I, WEBBER DOUGLTON

of RR-1, Box 326, ALBANY County of LINN

State of OREGON, do hereby make application for a certificate of registration as evidence of a right to appropriate ground water.

1. Source from which water is withdrawn is PUMP WELL NO. 1  
(Flowing well, pump well, infiltration trench, or tunnel)

2. Location is: 5 1/2 MILES N. OF LEBANON, ORE.  
(Approximate distance and direction from nearest city or town)

and is more particularly described as follows:

(a) 402' S. AND 1518' W. OF N.E. CORNER S. 16, T. 11 S, R. 2 W  
(Give distance and bearing to corner of section or other legal subdivision)

being within N.W. 1/4 OF NE 1/4 of Sec. 16, Twp. 11 S, Rge. 2 W  
(Smallest legal subdivision) (N. or S.) (E. or W.)

or (b) within limits of recorded platted property, town or city:

in Lot \_\_\_\_\_, Block \_\_\_\_\_ of \_\_\_\_\_  
(Name of plat or addition)

County of LINN  
(If within city or town, give name)

3. Construction Work was begun on 1945; was completed on 1945  
(Date) (Date)

and the ground water claimed was first used for the purposes set out below on 1945  
(Date)

since which time the water has been used CONTINUOUSLY  
(Continuously or intermittently)

from 1945 to PRESENT TIME  
(Date) (Date)

4. Quantity of water claimed and used is 500 gallons per minute; None acre feet per year.

5. Purpose or Purposes for which water is used IRRIGATION

(Domestic, irrigation, municipal, manufacturing, industrial, etc.)

6. Description of Well: Depth 35 feet. Type DRIILLED  
(Dug or drilled)

diameter 4 inches. Elevation of ground at well site 290 feet, mean sea level.  
(As near as known)

Depth to water table 8 feet.

7. Capacity of Well: 700 g.p.m. with 11 feet drawdown.

\_\_\_\_\_ g.p.m. with \_\_\_\_\_ feet drawdown.

Date of test 1945

If Flowing Well: Measured discharge \_\_\_\_\_ g.p.m. on \_\_\_\_\_  
(Date)


Shut-in pressure at ground surface \_\_\_\_\_ lbs. per sq. in. on \_\_\_\_\_  
(Date)

Water is controlled by \_\_\_\_\_  
(Cap, valve, etc.)





Township 11 S Range 2 W, W.M.  
North

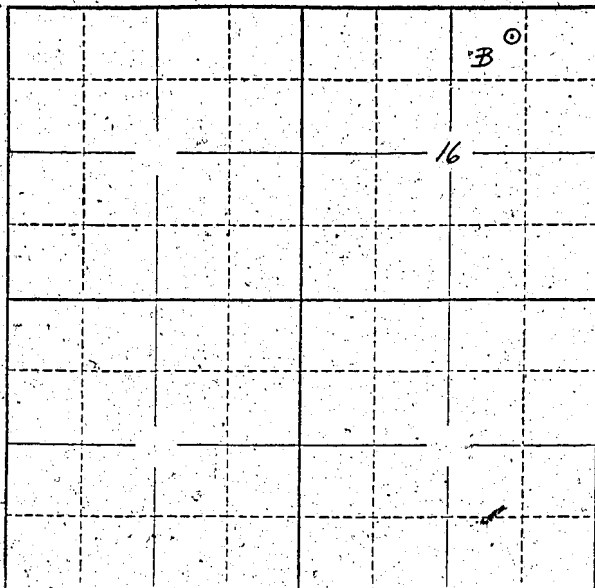

Locate well and acreage of irrigated land on plat.  
Scale: 2" = 1 Mile

STATE OF OREGON

County of Lincoln } ss.

I, WEBBER DOUGHTON, being first duly sworn, do hereby certify that I have read the foregoing Registration Statement and that all of the items therein contained are true to the best of my knowledge and belief.

Webber Doughton  
(Signature of Registrant)

Subscribed and sworn to before me this 26 day of July, 1958

My commission expires MY COMMISSION EXPIRES MAY 22, 1962

William F. Phillips  
(Notary Public)

(SEAL)

**CERTIFICATE OF REGISTRATION**

STATE OF OREGON

County of Marion } ss.

This is to certify that the foregoing Registration Statement was received in the office of the State Engineer on the 26 day of July, 1958, at 8:00 o'clock A.M. and has been duly recorded in said office in Book No. 13 of Registration Statements on page GR-2990

Witness my hand this 2nd day of June, 1959

Henry A. Stanley  
(State Engineer)

By \_\_\_\_\_ (Deputy)

# 21.00