

Registration Statement

OF CLAIMANT OF RIGHT TO APPROPRIATE GROUND WATER

TO THE STATE ENGINEER OF OREGON:

I, Orville E. and Esther Sheffield

of Rt. 1, Jefferson County of Linn

State of Oregon, do hereby make application for a certificate of registration as evidence of a right to appropriate ground water.

1. Source from which water is withdrawn is pump well
(Flowing well, pump well, infiltration trench, or tunnel)

2. Location is: 1/2 miles SE of Jefferson
(Approximate distance and direction from nearest city or town)

and is more particularly described as follows:

(a) N. 52° 30' W. 15.8 chains from SE corner of NE 1/4 of S. 12, T. 10 S., R. 2 W.
(Give distance and bearing to corner of section or other legal subdivision)

being within SE 1/4 of NE 1/4 of Sec. 19, Twp. 10 S., Rge. 2 W.
(Smallest legal subdivision) (N. or S.) (E. or W.)

or (b) within limits of recorded platted property, town or city:

in Lot _____, Block _____ of _____
(Name of plat or addition)

County of Linn
(If within city or town, give name)

3. Construction Work was begun on June 1915; was completed on June 1915
(Date) (Date)

and the ground water claimed was first used for the purposes set out below on June 1915
(Date)

since which time the water has been used continuously
(Continuously or intermittently)

from June 1915 to present time
(Date) (Date)

4. Quantity of water claimed and used is 300 gallons per minute; 80.0 acre feet per year.

5. Purpose or Purposes for which water is used irrigation

(Domestic, irrigation, municipal, manufacturing, industrial, etc.)

6. Description of Well: Depth 22 feet. Type Drilled
(Dug or drilled)

diameter 12 inches. Elevation of ground at well site 235 feet, mean sea level.
(As near as known)

Depth to water table 7 feet.

7. Capacity of Well: _____ g.p.m. with _____ feet drawdown.

_____ g.p.m. with _____ feet drawdown.

Date of test Not tested

If Flowing Well: Measured discharge _____ g.p.m. on _____
(Date)

Shut-in pressure at ground surface _____ lbs. per sq. in. on _____
(Date)

Water is controlled by _____
(Cap, valve, etc.)

If log of well is not available, give name and address of driller. unknown

11. Infiltration Trench: Covered or open

Dimensions: Length ft. Minimum depth ft. Maximum depth ft.

Bottom width ft. Discharge g.p.m. Date of test

12. Tunnel: Type of lining

Dimensions:
(Length, course, and cross sectional size)

Position of water bearing stratum with reference to portal of tunnel

Log of tunnel: (Preceding table for log of well may be used, if desired. Give footage from portal and character of materials, as pertinent.)

13. Pumping Equipment:

(a) Pump Fairbanks Morse 3" centrifugal Capacity 350 g.p.m.
(Make, type and size)

(b) Motor 15 H. P. electric
(Type and horsepower)

14. Location of area irrigated or to be irrigated, or place of use if for purposes other than irrigation.

Township North or South	Range E. or W. of Willamette Meridian	Section	Forty-acre Tract	Number Acres To Be Irrigated	Date of Reclamation
10 S	2 W	19	SE $\frac{1}{4}$ of NE $\frac{1}{4}$	27.0	June 1945
10 S	2 W	20	SW $\frac{1}{4}$ of NW $\frac{1}{4}$	30.0	" "
				30.0	

256-184 Sheffield


The northwest quarter of the southwest quarter of section 20 in T. 10 S., R. 2 W. of the Will. Mer. in Linn County, Oregon;

The west 100 rods of the northwest quarter of section 20 in T. 10 S., R. 2 W. of the Will. Mer. in Linn County, Oregon, except that portion thereof conveyed to Olen J. Cox of deed recorded in Book 252, page 792.

The southeast quarter of the northeast quarter and the south 2 $\frac{1}{2}$ chains of the northeast quarter of the northeast quarter of section 19 in T. 10 S., R. 2 W. of the Will. Mer. in Linn County, Oregon, beginning 15.00 chains south of the northeast corner of the northeast quarter of section 19 in T. 10 S., R. 2 W. of the Will. Mer. in Linn County, Oregon; and running thence south 185 feet; thence N. 88° 43' W. 1010.40 feet to the west line of the north east quarter of the northeast quarter of said section; thence north 10 $\frac{1}{2}$ feet; thence N. 84° 50' 30" E. 1524.20 feet to the place of beginning, all in Linn County, Oregon;

15. If the ground water supply is supplemental to an existing water supply, identification of any application for a permit, permit, certificate or adjudicated right to appropriate water made or held by the registrant.

Township 10 S Range 2 W, W.M.
North

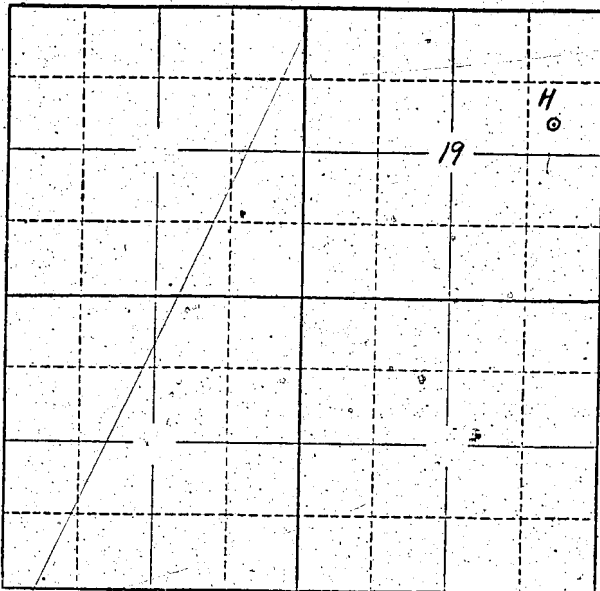

Locate well and acreage of irrigated land on plat.
Scale: 2" = 1 Mile

STATE OF OREGON

County of _____ } ss.

I, Orville B. and Esther S. Sheffield, being first duly sworn, do hereby certify that I have read the foregoing Registration Statement and that all of the items therein contained are true to the best of my knowledge and belief.

Orville B. Sheffield

(Signature of Registrant)

Subscribed and sworn to before me this 23rd day of July, 1958.

My commission expires _____

W. B. [Signature]

(Notary Public)

(SEAL)

CERTIFICATE OF REGISTRATION

STATE OF OREGON

County of Marion } ss.

This is to certify that the foregoing Registration Statement was received in the office of the State Engineer on the 23rd day of July, 1958, at 1:00 o'clock P.M. and has been duly recorded in said office in Book No. 13 of Registration Statements on page OR-2996

Witness my hand this 2nd day of June, 1959

\$1,500

Lewis A. Stanley

(State Engineer)

By _____

(Deputy)