

Registration Statement

OF CLAIMANT OF RIGHT TO APPROPRIATE GROUND WATER

Well # 2

TO THE STATE ENGINEER OF OREGON:

I, Mrs. Minnie J. Funke

of Rt. 2, Box 375 Eugene County of Lane

State of Oregon do hereby make application for a certificate of registration as evidence of a right to appropriate ground water.

1. Source from which water is withdrawn is Pump well
(Flowing well, pump well, infiltration trench, or tunnel)

2. Location is: One mile S. of Coburg School House
(Approximate distance and direction from nearest city or town)

and is more particularly described as follows:

(a) S. 1260; W. 1950 Ft from the N. E. corner of Sec 5 T 17 S; R 3 W
(Give distance bearing to corner of section or other legal subdivision)

being within NE of Sec. 5, Twp. 17 S, Rge. 3 W
(Smallest legal subdivision) (N. or S.) (E. or W.)

or (b) within limits of recorded platted property, town or city:

in Lot, Block of
(Name of plat or addition)

County of
(If within city or town, give name)

3. Construction Work was begun on 1937; was completed on 1937
(Date) (Date)

and the ground water claimed was first used for the purposes set out below on 1937
(Date)

since which time the water has been used intermittently
(Continuously or intermittently)

from April to October each year
(Date) (Date)

4. Quantity of water claimed and used is 360 gallons per minute; 39.35 acre feet per year.

5. Purpose or Purposes for which water is used Irrigation

(Domestic, irrigation, municipal, manufacturing, industrial, etc.)

6. Description of Well: Depth 21 feet. Type driven
(Dug or drilled)

Three 2" pipes 6' apart coupled diameter inches. Elevation of ground at well site 380 feet, mean sea level.
(As near as known)

Depth to water table 10 feet.

7. Capacity of Well: g.p.m. with feet drawdown.
g.p.m. with feet drawdown.

Date of test not tested

If Flowing Well: Measured discharge g.p.m. on
(Date)

Shut-in pressure at ground surface lbs. per sq. in. on
(Date)

Water is controlled by
(Cap, valve, etc.)

8. Casing: (Give diameter, commercial specifications and depth below ground surface of each casing size.)

..... inch diameter from to feet
..... inch diameter from to feet
..... inch diameter from to feet
..... inch diameter from to feet

Describe and show depth of shoe, plug, adapter, liner or other details:

.....

.....

9. Perforated Casings or Screens:

drilled 2" holes 16 per ft from 17.5 to 21
(Number per foot and size of perforations, or describe screen)

..... from to

..... from to

..... from to

10. Log of Well: (Describe each stratum or formation clearly, indicate if water bearing, and give thickness and depth as indicated.)

MATERIAL	Thickness (Feet)	Depth to Bottom (Feet)

If log of well is not available, give name and address of driller.

11. Infiltration Trench: Covered or open

Dimensions: Length ft. Minimum depth ft. Maximum depth ft.

Bottom width ft. Discharge g.p.m. Date of test

12. Tunnel: Type of lining

Dimensions: (Length, course, and cross sectional size)

Position of water bearing stratum with reference to portal of tunnel

Log of tunnel: (Preceding table for log-of well may be used, if desired. Give footage from portal and character of materials, as pertinent.)

13. Pumping Equipment:

(a) Pump Fairbanks Morse, Centrifugal 4" X 3" Capacity 350 g.p.m. (Make, type and size)

(b) Motor Gasoline 26 hp (Type and horsepower)

14. Location of area irrigated or to be irrigated, or place of use if for purposes other than irrigation.


Table with 6 columns: Township North or South, Range E. or W. of Willamette Meridian, Section, Forty-acre Tract, Number Acres To Be Irrigated, Date of Reclamation. Includes handwritten entries for NE 1/4 and NW 1/4 NE 1/4.

15. If the ground water supply is supplemental to an existing water supply, identification of any application for a permit, permit, certificate or adjudicated right to appropriate water made or held by the registrant.

Both No. 1 and No. 2 wells are used on the same acres; one supplements the other.

SEE ATTACHED MAP
Township 17.S Range 3W W.M.

North

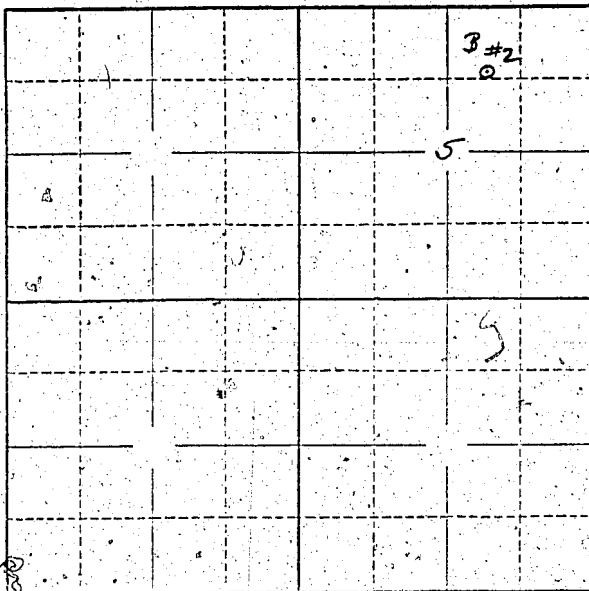

Locate well and acreage of irrigated land on plat.

Scale: 2" = 1 Mile

STATE OF OREGON

County of Lane } ss.

I, Mrs. Minnie J. Funke, being first duly sworn, do hereby certify that I have read the foregoing Registration Statement and that all of the items therein contained are true to the best of my knowledge and belief.

Mrs. Minnie J. Funke
(Signature of Registrant)

Subscribed and sworn to before me this 29th day of June, 1958

My commission expires April 14, 1961

[Signature]
(Notary Public)

(SEAL)

CERTIFICATE OF REGISTRATION

STATE OF OREGON

County of Marion } ss.

This is to certify that the foregoing Registration Statement was received in the office of the State Engineer on the 30th day of July, 1958, at 9:00 o'clock A. M. and has been duly recorded in said office in Book No. 13 of Registration Statements on page GR-2998

Witness my hand this 2nd day of June, 1959

Lewis A. Stanley
(State Engineer)

\$15.00

By _____ (Deputy)

GR - 2998